

LAND CORNER RECORDATION CERTIFICATE  
Filing Requirement of Act 74, Mich. P.A. 1970

*Liber 7 Page 81*

For corners in

Saginaw (County)	Located In:	Corner Code #
Kochville Township		
1. Public Land Survey	T 13N R 4E	B-7
	T R	
	T R	
	T R	
	T R	
2. Property Controlling in Section	S T R	
	S T R	
3. Miscellaneous Property in Sec.	S T R	
	S T R	

RECORDED & FILED  
SEP 27 11 44 AM 1986  
MILFORD M. DODAK  
REGISTER OF DEEDS  
SAGINAW COUNTY MICH.

Register of Deeds Stamp & File Number

4. Lot No. \_\_\_\_\_, Recorded Plat \_\_\_\_\_  
5. Private Claims \_\_\_\_\_

I, Michael J. MacDonald, in a field survey on August 16, 1996 do hereby state that under requirements of P.A. 74, Michigan P.A. of 1970, the corner points mentioned in lines 1 and 2 above were in conformance with regulations and rules therefore as required in the current manual of survey instructions of the United States Department of the Interior, Bureau of Land Management or by a decree of a Court of Law and for that the corner points mentioned in lines 3, 4 and 5 above were in conformance with the rules of the Michigan Board of Land Surveyors or by a Decree of a Court of Law; established, re-established, monumented, recovered, found as expressed below:

	A	B	C	D	E	F	G	H	I	J	K	L	M
1													
2	6		5		4		3		2		1		
3													
4	7		8		9		10		11		12		
5													
6	18		17		16		15		14		13		
7	•												
8	19		20		21		22		23		24		
9													
10	30		29		28		27		26		25		
11													
12	31		32		33		34		35		36		
13													

NOTE: Not more than 2 corners, all in the same town and range, may be recorded on this certificate.

A. Description of original monument and accessories and/or subsequent restoration:

B-7 Post set by - J. Wampler D.S. in 1840.

L.C.R.C. - L. 2, P. 111- by John Martin, fnd 1/2" pipe. (Saginaw County)  
Recorded Surveys: L. 1446, P. 687; L. 1392, P. 538. (Saginaw County)

L.C.R.C. - L. 2, P. 177, by John Martin, fnd 3/4" pipe. (Bay County)  
Recorded Surveys: L. 674, P. 322; L. 1075, P. 474. (Bay County)

B. Description of corner evidence found and/or method applied in restoring or reestablishing corner:


B-7 Fnd 3/4" pipe in monument box.

Recorded Witnesses as follows:  
S 05° W (South -R) 50.05' to nail and tag (49.87' - R to face) in U.P.  
2624.35' (2624.5' - R) East to C-7.  
Monument accepted as the best available evidence of the position of the original corner.

C. Description of monument for corner and accessories established to perpetuate locating the position of the corner:

B-7 Replaced 3/4" pipe with Saginaw County Remonumentation cap on 5/8" x 18" long rebar in monument box.

S 05° E 50.09' to nail and tag in W face of pole.  
S 35° E 88.60' to nail and tag in NE face of 6" pipe.  
N 35° E 37.71' to nail and tag in E face of 18" Maple.  
N 55° W 68.84' to nail and tag in SW face of 15" Maple.

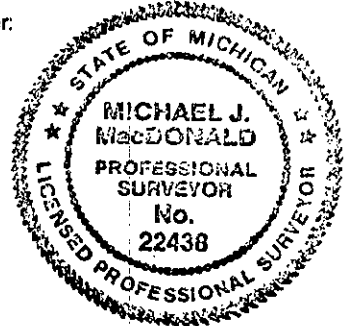

Signed by Michael J. MacDonald  
Surveyor's Michigan License No. 22438

Date 25 Sept 96

MAY 16 1997