

Saginaw County Remonumentation
LAND CORNER RECORDATION CERTIFICATE
Filing Requirement of Act 74, Mich. P.A. 1970

Liber 7 Page 80

For corners in

Saginaw
(County)
Kochville Township
1. Public Land Survey


Located In:	Corner Code #
T <u>13NR</u> <u>4E</u>	<u>D-7</u>
T <u> </u> <u> </u>	<u> </u>
T <u> </u> <u> </u>	<u> </u>
T <u> </u> <u> </u>	<u> </u>
T <u> </u> <u> </u>	<u> </u>
S <u> </u> <u> </u>	<u> </u>
S <u> </u> <u> </u>	<u> </u>
S <u> </u> <u> </u>	<u> </u>
S <u> </u> <u> </u>	<u> </u>

RECORDED & FILED
SEP 27 11 44 AM 1996
HILDED N. CORDAK
REGISTER OF DEEDS
SAGINAW COUNTY MICH.
Register of Deeds Stamp & File Number

4. Lot No. _____, Recorded Plat _____
5. Private Claims _____

I, Michael J. MacDonald, in a field survey on August 16, 1996 do hereby state that under requirements of P.A. 74, Michigan P.A. of 1970, the corner points mentioned in lines 1 and 2 above were in conformance with regulations and rules therefore as required in the current manual of survey instructions of the United States Department of the Interior, Bureau of Land Management or by a decree of a Court of Law and/or that the corner points mentioned in lines 3, 4 and 5 above were in conformance with the rules of the Michigan Board of Land Surveyors or by a Decree of a Court of Law; established, re-established, monumented, recovered, found as expressed below:

NOTE: Not more than 2 corners, all in the same town and range, may be recorded on this certificate.

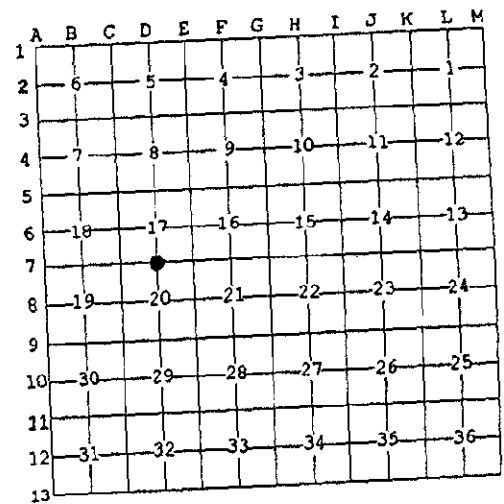

A. Description of original monument and accessories and/or subsequent restoration:

D-7 Post set by J. Wampler D.S. in 1822.
L.C.R.C. - L. 3, P. 123 - J. Martin fnd 3/4" pipe. (Saginaw County)
Saginaw County Road Commission Notes: 1975 fnd 3/4" pipe.
Recorded Surveys: L. 1584, P. 2036; L. 1445, P. 121. (Saginaw County)

L.C.R.C. - L. 2, P. 269 - M. MacDonald fnd 1" pipe. (Bay County)
Recorded Surveys: L. 834, P. 459. (Bay County)


B. Description of corner evidence found and/or method applied in restoring or reestablishing corner:

D-7 Fnd 3/4" pipe 14" long 0.10' below surface 0.25' S and 0.40' E of ctr of empty monument box per Spicer survey notes dated June 1993. Also fnd 3/4" x 14" long pipe 11" deep 0.20' S and 0.20' W of pipe near surface.
No remaining recorded witnesses.

Spicer notes from June 1993 - reset corner on line between C-7 and E-7 at 2661.16' E to E-7 (meas. 2661.69') and 2656.53' W to C-7 (meas. 2656.63').
Pipe near surface accepted as best available evidence of the position of the original corner.

C. Description of monument for corner and accessories established to perpetuate locating the position of the corner:

D-7 Replace pipe near surface with Saginaw County Remonumentation cap on 5/8" x 18" long rebar in monument box.
S 0.30' to N edge of 24' wide bit. pavement.
S 73° E 144.57' to nail and tag in N face of pole.
S 75° W 170.42' to nail and tag in N face of pole.
N 04°30' E 28.75' to nail and tag in E face of pole.

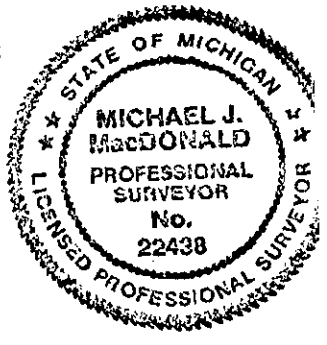

Signed by Michael J. MacDonald
Surveyor's Michigan License No. 22438

Date 25 Sept 96

SURVEY &
REMONUMENTATION

MAY 16 1997