APPROVED BY PEER GROUP
P.A. 345 OF 1990
SAGINAW COUNTY
7-21

RECORDED/FILED

SAGINAW COUNTY REMONUMENTATION

LAND CORNER RECORDATION CERTIFICATE

Filing Requirement of Act 74, Mich. P.A. 1970

1999 SEP 29 A 8:08

MILDRED M. DODAK
REGISTER OF DEEDS
SAGINAW COUNTY, MI.

LIBER 2144 PAGE 789

Liber 8 Page 54

Register of Deeds Stamp & File Number

For corners in

SAGINAW (County)

KOCHVILLE TOWNSHIP

	Located in:	Corner Code #
1. Public Land Survey	T13 N R 4 E	D-11
	T___ R___	
2. Property Controlling	S___ T___ R___	
in Section	S___ T___ R___	
3. Miscellaneous	S___ T___ R___	
Property in Sec.	S___ T___ R___	

4. Lot No._____, Recorded Plat_____
5. Private Claims_____

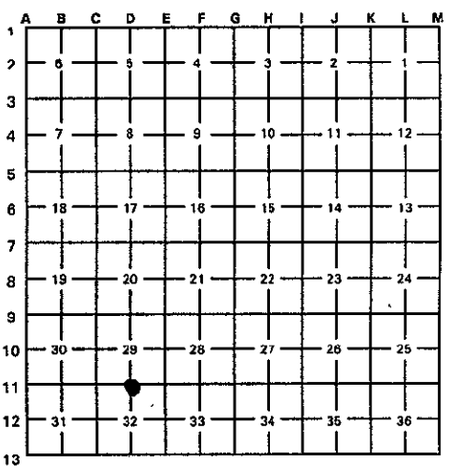

I, Brian D Ferguson, in a field survey on JUNE 28, 19 99 do hereby state that under requirements of P.A. 74, Michigan P.A. of 1970, the corner points mentioned in lines 1 and 2 above were in conformance with regulations and rules therefore as required in the current manual of survey instructions of the United States Department of the Interior, Bureau of Land Management or by a decree of a Court of Law and/or that the corner points mentioned in lines 3, 4 and 5 above were in conformance with the rules of the Michigan Board of Land Surveyors or by a Decree of a Court of Law; established, re-established, monumented, recovered, found as expressed below:

NOTE: Not more than 2 corners, all in the same town and range, may be recorded on this certificate.

A. Description of original monument and accessories and/or subsequent restoration:

WOOD POST SET BY J. WAMPLER IN 1822, NO EVIDENCE OF ORIGINAL CORNER REMAINS
LCRC BY JOHN MARTIN IN 1974, L 2, PG 241

SURVEY &
RF N
MAR 0 9 2000
SECTION

B. Description of corner evidence found and/or method applied in restoring or reestablishing corner:

FOUND 3/4" PIPE
ALL WITNESSES FROM LCRC AND RECORDED SURVEYS ARE GONE. LOCATION VERIFIED BY RECORDED DISTANCES TO ADJOINING SECTION CORNERS
WITNESSES FROM UN-RECORDED SURVEY BY RC ASSOCIATES IN 1991 VERIFIED LOCATION OF CORNER

ACCEPTED BY PEER GROUP AS THE BEST AVAILABLE EVIDENCE OF THE POSITION OF THE ORIGINAL CORNER

C. Description of monument for corner and accessories established to perpetuate locating the position of the corner:

SET 5/8" REBAR W/ 3" BRASS CAP IN MONUMENT BOX
NORTH 46.86' SET NAIL IN WEEDS
SOUTH 32.90' LC/SPICER
S35E 47.55' NAIL IN NW FCE 10" MAPLE
S55W 39.20' TOP CTR END 40" CONC CULVERT

STATE OF MICHIGAN
BRIAN D FERGUSON
LAND SURVEYOR
NO. 26454
PROFESSIONAL SURVEYOR

Signed by B D Ferguson
Date SEPTEMBER 28, 1999
Surveyor's Michigan License No. 26454

FORM APPROVED BY MICHIGAN STATE BOARD OF PROFESSIONAL SURVEYORS, JAN. 28, 1971
REVISED MAY 14, 1975
REVISED JAN., 1983
REVISED OCT., 1995