

6-30/2000

SAGINAW COUNTY REMONUMENTATION

RECORDED/FILED

LAND CORNER RECORDATION CERTIFICATE
Filing Requirement of Act 74, Mich. P.A. 1970

1999 SEP 29 A 8 08

For corners in

KOCHVILLE TOWNSHIP

Located in: Corner Code #

MILDRED M. DODAK
REGISTER OF DEEDS
SAGINAW COUNTY, MI.

SAGINAW (County)	Located in:	Corner Code #
1. Public Land Survey	T13 N R 4 E	E-9
	T R	
2. Property Controlling in Section	S T R	
	S T R	
3. Miscellaneous Property in Sec.	S T R	
	S T R	

LIBER 2144 PAGE 783

Liber 8 Page 48
Register of Deeds Stamp & File Number

4. Lot No. _____, Recorded Plat _____
5. Private Claims _____

I, Brian D Ferguson, in a field survey on JUNE 28, 19 99 do hereby state that under requirements of P.A. 74, Michigan P.A. of 1970, the corner points mentioned in lines 1 and 2 above were in conformance with regulations and rules therefore as required in the current manual of survey instructions of the United States Department of the Interior, Bureau of Land Management or by a decree of a Court of Law and/or that the corner points mentioned in lines 3, 4 and 5 above were in conformance with the rules of the Michigan Board of Land Surveyors or by a Decree of a Court of Law; established, re-established, monumented, recovered, found as expressed below:

	A	B	C	D	E	F	G	H	I	J	K	L	M
1													
2	6		5		4		3		2		1		
3													
4	7		8		9		10		11		12		
5													
6	18		17		16		15		14		13		
7													
8	19		20		21		22		23		24		
9					●								
10	30		29		28		27		26		25		
11													
12	31		32		33		34		35		36		
13													

NOTE: Not more than 2 corners, all in the same town and range, may be recorded on this certificate.

A. Description of original monument and accessories and/or subsequent restoration:

- E-9 WOOD POST SET BY J. WAMPLER IN 1822, NO EVIDENCE OF ORIGINAL CORNER REMAINS
LCRC BY EUGENE GOSS IN 1973, L 2, PG 147
LCRC BY RON PREVOST IN 1981, L 3, PG 110

SURVEY &
RECORDATION

MAR 09 2000

B. Description of corner evidence found and/or method applied in restoring or reestablishing corner:


- E-9 FOUND 3/4" PIPE IN MONUMENT BOX
VERIFIED LOCATION FROM LCRC BY PREVOST IN L 3, PG 110

SECTION

ACCEPTED BY PEER GROUP AS THE BEST AVAILABLE EVIDENCE OF THE POSITION OF THE ORIGINAL CORNER

C. Description of monument for corner and accessories established to perpetuate locating the position of the corner:

- E-9 SET 5/8" REBAR W/ 3" BRASS CAP IN MONUMENT BOX
S40E 63.00' NAIL IN NW FCE PWR POLE
S35W 24.95' NAIL IN NW COR CONC CULVERT
N40W 41.58' NAIL IN SE FCE PWR POLE
N60E 54.15' NAIL IN W FCE PWR POLE

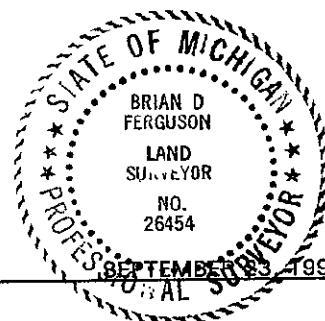

Signed by Brian D Ferguson
Surveyor's Michigan License No. 26454

Date SEPTEMBER 23, 1999