

*9-22 BDF*

SAGINAW COUNTY REMONUMENTATION

RECORDED/FILED

LAND CORNER RECORDATION CERTIFICATE

Filing Requirement of Act 74, Mich. P.A. 1970

1999 SEP 29 A 8:08

For corners in

KOCHVILLE TOWNSHIP

Located in: Corner Code #

MILDRED M. DODAK  
REGISTER OF DEEDS  
SAGINAW COUNTY, MI.

LIBER 2144 PAGE 785

*Lib 8 Page 50*

Register of Deeds Stamp & File Number

<u>SAGINAW</u> (County)	Located in:	Corner Code #
1. Public Land Survey	T <u>13 N</u> R <u>4 E</u>	<u>E-12</u>
2. Property Controlling in Section	S <u>    </u> T <u>    </u> R <u>    </u>	<u>    </u>
3. Miscellaneous Property in Sec.	S <u>    </u> T <u>    </u> R <u>    </u>	<u>    </u>

4. Lot No. \_\_\_\_\_, Recorded Plat \_\_\_\_\_  
5. Private Claims \_\_\_\_\_

I, Brian D Ferguson, in a field survey on SEPT. 21, 19 99 do hereby state that under requirements of P.A. 74, Michigan P.A. of 1970, the corner points mentioned in lines 1 and 2 above were in conformance with regulations and rules therefore as required in the current manual of survey instructions of the United States Department of the Interior, Bureau of Land Management or by a decree of a Court of Law and/or that the corner points mentioned in lines 3, 4 and 5 above were in conformance with the rules of the Michigan Board of Land Surveyors or by a Decree of a Court of Law; established, re-established, monumented, recovered, found as expressed below:

NOTE: Not more than 2 corners, all in the same town and range, may be recorded on this certificate.

A	B	C	D	E	F	G	H	I	J	K	L	M
1												
2	6		5		4		3		2		1	
3												
4	7		8		9		10		11		12	
5												
6	18		17		16		15		14		13	
7												
8	19		20		21		22		23		24	
9												
10	30		29		28		27		26		25	
11												
12	31		32		33		34		35		36	
13												

A. Description of original monument and accessories and/or subsequent restoration:

WOOD POST SET BY J WAMPLER IN 1822, NO EVIDENCE OF ORIGINAL CORNER REMAINS  
LCRC BY GERALD MCKELVEY IN 1972, L 1, PG 210  
SURVEYS RECORDED IN L1370, PG 268 AND L 1571, PG 172  
VARIOUS OTHER UN-RECORDED SURVEYS


RECORDED &  
MAY 9 2000  
SECTION

B. Description of corner evidence found and/or method applied in restoring or reestablishing corner:

NO CORNER FOUND. RE-ESTABLISHED POSITION FROM WITNESSES ON LCRC. COMPARED LOCATION WITH VARIOUS UNRECORDED SURVEYS. DISTANCE TO NORTH AGREES WITH UNRECORDED SURVEYS AS DOES DISTANCE TO SOUTH. CORNER IS ON A STRAIGHT LINE BETWEEN E-11 AND E-13

C. Description of monument for corner and accessories established to perpetuate locating the position of the corner:

SET 5/8" REBAR W/ 3" BRASS CAP IN MONUMENT BOX  
N70E 28.12' NW COR CONC SLAB  
N40E 58.99' TOP CTR HYDRANT  
N80W 35.73' SE LEG S'LY TWR  
N45W 71.81' SE LET N'LY TWR

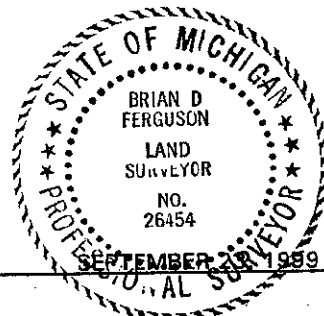

Signed by Brian D Ferguson  
Surveyor's Michigan License No. 26454

Date SEPTEMBER 23 1999