

Saginaw County Remonumentation

LAND CORNER RECORDATION CERTIFICATE
Filing Requirement of Act 74, Mich. P.A. 1970

Liber 7 Page 78

For corners in

Saginaw (County)	Located In:	Corner Code #
Kochville Township	T 13NR 4E	G-7
1. Public Land Survey	T ___ R ___	___
	T ___ R ___	___
	T ___ R ___	___
2. Property Controlling in Section	S ___ T ___ R ___	___
	S ___ T ___ R ___	___
3. Miscellaneous Property in Sec.	S ___ T ___ R ___	___
	S ___ T ___ R ___	___

RECORDED & FILED
 SEP 27 11 44 AM 1996
 HILDECO N. GODAK
 REGISTER OF DEEDS
 SAGINAW COUNTY MICH.
 Register of Deeds Stamp & File Number

4. Lot No. _____, Recorded Plat _____
5. Private Claims _____

I, Michael J. MacDonald, in a field survey on August 20, 1996 do hereby state that under requirements of P.A. 74, Michigan P.A. of 1970, the corner points mentioned in lines 1 and 2 above were in conformance with regulations and rules therefore as required in the current manual of survey instructions of the United States Department of the Interior, Bureau of Land Management or by a decree of a Court of Law and/or that the corner points mentioned in lines 3, 4 and 5 above were in conformance with the rules of the Michigan Board of Land Surveyors or by a Decree of a Court of Law; established, re-established, monumented, recovered, found as expressed below:

	A	B	C	D	E	F	G	H	I	J	K	L	M
1													
2	6		5		4		3		2		1		
3													
4	7		8		9		10		11		12		
5													
6	18		17		16		15		14		13		
7													
8	19		20		21		22		23		24		
9													
10	30		29		28		27		26		25		
11													
12	31		32		33		34		35		36		
13													

NOTE: Not more than 2 corners, all in the same town and range, may be recorded on this certificate.

A. Description of original monument and accessories and/or subsequent restoration:
G-7 Post set by J. Wampler D.S. in 1822.
L.C.R.C. - L. 3, P. 60 - by A. Leach set PK nail. (Saginaw County)
Recorded Surveys - L. 1215, P. 288 (Saginaw County)
Recorded Surveys: L. 860, P. 42; L. 808, P. 442; L. 794, P. 12;
L. 805, P. 214; L. 861, P. 437. (Bay County)


B. Description of corner evidence found and/or method applied in restoring or reestablishing corner:

G-7 Found 3/4" boat spike in monument box per recorded surveys and Spicer Witnesses (1975). PK nail in L.C.R.C. - L. 3, P. 60 (1974) not found - position in conflict with found corner shown in subsequent surveys.

Recorded Witnesses as follows:
NE 47.70' (47.7' - R)(47.8' - R)(47.71' - Spicer) to nail and tag in S face of UP. SW 72.35' (72.4' - R)(71.9' - R)(71.8' - Spicer) to nail and tag in SE side of UP. Boat spike accepted as best available evidence of the position of the original corner.

C. Description of monument for corner and accessories established to perpetuate locating the position of the corner:

G-7 Replaced boat spike in monument box with Bay County Remonumentation cap on 5/8" x 24" rebar.
N 50° E 47.89' to nail and tag in SW face of pole.
S 70° E 230.64' to nail and tag in N face of pole.
S 45° W 72.37' to nail and tag in SE face of pole.
S 65° W 73.03' to chiseled "x" in S rim of water valve box.

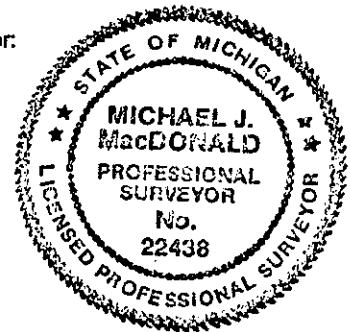

Signed by Michael J. MacDonald
Surveyor's Michigan License No. 22438

Date 25 Sept 96

REMONUMENTATION

MAY 16 1997