

APPROVED BY PEER GROUP
P.A. 345 OF 1990
SAGINAW COUNTY

9-1 [Signature]

SAGINAW COUNTY REMONUMENTATION

RECORDED/FILED

LAND CORNER RECORDATION CERTIFICATE Filing Requirement of Act 74, Mich. P.A. 1970

1999 SEP 29 A 8 06

For corners in

KOCHVILLE TOWNSHIP

<u>SAGINAW</u> (County)	Located in:	Corner Code #
1. Public Land Survey	<u>T13 N R 4 E</u>	<u>G-10</u>
	T <u> </u> R <u> </u>	<u> </u>
2. Property Controlling in Section	S <u> </u> T <u> </u> R <u> </u>	<u> </u>
	S <u> </u> T <u> </u> R <u> </u>	<u> </u>
3. Miscellaneous Property in Sec.	S <u> </u> T <u> </u> R <u> </u>	<u> </u>
	S <u> </u> T <u> </u> R <u> </u>	<u> </u>

MILDRED M. DODAK
REGISTER OF DEEDS
SAGINAW COUNTY, MI.

LIBER 2144 PAGE 763


Liber 8 Page 28

Register of Deeds Stamp & File Number

- 4. Lot No. _____, Recorded Plat _____
- 5. Private Claims _____

I, Brian D Ferguson, in a field survey on JUNE 30, 19 99 do hereby state that under requirements of P.A. 74, Michigan P.A. of 1970, the corner points mentioned in lines 1 and 2 above were in conformance with regulations and rules therefore as required in the current manual of survey instructions of the United States Department of the Interior, Bureau of Land Management or by a decree of a Court of Law and/or that the corner points mentioned in lines 3, 4 and 5 above were in conformance with the rules of the Michigan Board of Land Surveyors or by a Decree of a Court of Law; established, re-established, monumented, recovered, found as expressed below:

NOTE: Not more than 2 corners, all in the same town and range, may be recorded on this certificate.

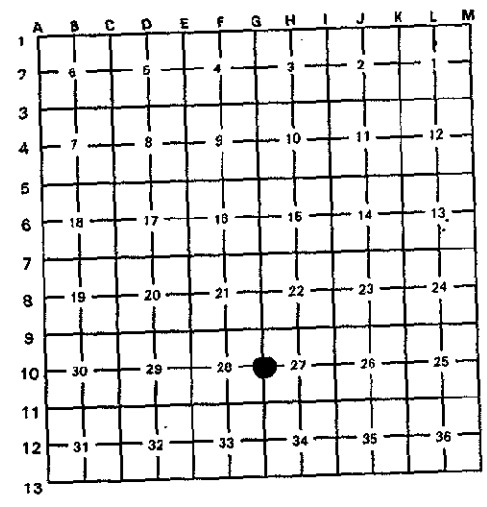

A. Description of original monument and accessories and/or subsequent restoration:

WOOD POST SET BY J. WAMPLER IN 1822, NO EVIDENCE OF ORIGINAL CORNER REMAINS
LCRC BY EUGENE GOSS IN 1973, L 2, PG 147
LCRC BY JOHN RAUSER IN 1999, UNKNOWN L & PG
SURVEY RECORDED IN L 1541, PG 670

RECORDED &
INDEXED
MAR 9 2000

SECTION

B. Description of corner evidence found and/or method applied in restoring or reestablishing corner:

FOUND 3/4" PIPE IN MONUMENT BOX PER WITNESS BOTH LCRC'S. VERIFIED LOCATION BY DISTANCES TO ADJOINING SECTION CORNERS FROM SECTION BREAKS BY LEACH

C. Description of monument for corner and accessories established to perpetuate locating the position of the corner:

- SET 5/8" REBAR W/ 3" BRASS CAP IN MONUMENT BOX
- S70E 29.45' TOP CTR AMERITECH RISER
- S70E 30.22' NAIL IN N FCE PWR POLE
- N65E 35.60' PK NAIL S FCE WOOD POST
- N60W 61.84' NAIL IN N FCE PWR POLE

Signed by [Signature]
Surveyor's Michigan License No. 26454

Date _____

