

APPROVED BY PEER GROUP  
P.A. 345 OF 1990  
SAGINAW COUNTY

9-1 BDF

SAGINAW COUNTY REMONUMENTATION

RECORDED/FILED

LAND CORNER RECORDATION CERTIFICATE

Filing Requirement of Act 74, Mich. P.A. 1970

1999 SEP 29 A 8 06

For corners in

<u>SAGINAW</u> (County)	Located in: <u>KOCHVILLE TOWNSHIP</u>	Corner Code #
1. Public Land Survey	<u>T13 N R 4 E</u>	<u>G-12</u>
	<u>T</u> <u>R</u>	
2. Property Controlling in Section	<u>S</u> <u>T</u> <u>R</u>	
	<u>S</u> <u>T</u> <u>R</u>	
3. Miscellaneous Property in Sec.	<u>S</u> <u>T</u> <u>R</u>	
	<u>S</u> <u>T</u> <u>R</u>	

MILDRED M. DOBAK  
REGISTER OF DEEDS  
SAGINAW COUNTY, MI.

LIBER 2144 PAGE 765

*Lib 8 Page 30*

Register of Deeds Stamp & File Number

4. Lot No. \_\_\_\_\_, Recorded Plat \_\_\_\_\_
5. Private Claims \_\_\_\_\_

I, Brian D Ferguson, in a field survey on JUNE 30, 1999 do hereby state that under requirements of P.A. 74, Michigan P.A. of 1970, the corner points mentioned in lines 1 and 2 above were in conformance with regulations and rules therefore as required in the current manual of survey instructions of the United States Department of the Interior, Bureau of Land Management or by a decree of a Court of Law and/or that the corner points mentioned in lines 3, 4 and 5 above were in conformance with the rules of the Michigan Board of Land Surveyors or by a Decree of a Court of Law; established, re-established, monumented, recovered, found as expressed below:

NOTE: Not more than 2 corners, all in the same town and range, may be recorded on this certificate.

	A	B	C	D	E	F	G	H	I	J	K	L	M
1													
2	6		5		4		3		2		1		
3													
4	7		8		9		10		11		12		
5													
6	18		17		16		15		14		13		
7													
8	19		20		21		22		23		24		
9													
10	30		29		28		27		26		25		
11													
12	31		32		33		34		35		36		
13													

A. Description of original monument and accessories and/or subsequent restoration:

WOOD POST SET BY J. WAMPLER IN 1822, NO EVIDENCE OF ORIGINAL CORNER REMAINS  
LCRC BY GERALD MCKELVEY IN 1972, L 1, PG 199  
LCRC BY JOHN RAUSER IN 1999, UNKNOWN L & PG  
SURVEYS RECORDED IN L 1568, PG 117, L 1636, PG 1863 & L 1800, PG1813

DAVEY & ...  
SEP 29 2000  
SECTION


B. Description of corner evidence found and/or method applied in restoring or reestablishing corner:

FOUND 3/4" ROD IN MONUMENT BOX PER WITNESSES ON LCRC'S. VERIFIED LOCTION WITH DISTANCES TO ADJOINING SECTION CORNERS FROM DISTANCES ON RECORDED AND UN-RECORDED SURVEYS.

ACCEPTED BY PEER GROUP AS THE BEST AVAILABLE EVIDENCE OF THE POSITION OF THE ORIGINAL CORNER

C. Description of monument for corner and accessories established to perpetuate locating the position of the corner:

SET 5/8" REBAR W/ 3" BRASS CAP IN MONUMENT BOX  
N45W 70.07' NAIL & TAG #19001 SW FACE PWR POLE  
WEST 30.02' NAIL & TAG #19001 IN N FCE PWR POLE  
EAST 33.15' T-IRON (PROPERTY CORNER)  
N32E 63.52' NAIL & TAG #19001 IN NW FCE PWR POLE

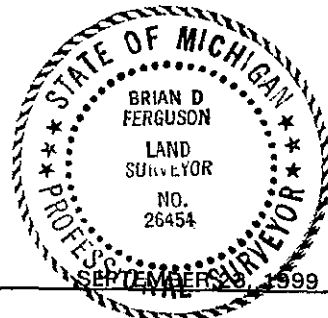

Signed by Brian D Ferguson

Date \_\_\_\_\_

Surveyor's Michigan License No. 26454