

APPROVED BY PEER GROUP  
P.A. 345 OF 1990  
SAGINAW COUNTY

7-21 BDF

### SAGINAW COUNTY REMONUMENTATION

### LAND CORNER RECORDATION CERTIFICATE Filing Requirement of Act 74, Mich. P.A. 1970

RECORDED/FILED

1999 SEP 29 A @ 06

MILDRED M. DODAK  
REGISTER OF DEEDS  
SAGINAW COUNTY, MI.

LIBER 2144 PAGE 766

*Liber 8 Page 31*

Register of Deeds Stamp & File Number

For corners in

<u>SAGINAW</u> (County)	Located in: <u>KOCHVILLE TOWNSHIP</u>	Corner Code # _____
1. Public Land Survey	<u>T13 N R 4 E</u>	<u>H-9</u>
	<u>T _____ R _____</u>	_____
2. Property Controlling in Section	<u>S _____ T _____ R _____</u>	_____
	<u>S _____ T _____ R _____</u>	_____
3. Miscellaneous Property in Sec.	<u>S _____ T _____ R _____</u>	_____
	<u>S _____ T _____ R _____</u>	_____

4. Lot No. \_\_\_\_\_, Recorded Plat \_\_\_\_\_

5. Private Claims \_\_\_\_\_

I, Brian D Ferguson, in a field survey on JUNE 30, 1999 do hereby state that under requirements of P.A. 74, Michigan P.A. of 1970, the corner points mentioned in lines 1 and 2 above were in conformance with regulations and rules therefore as required in the current manual of survey instructions of the United States Department of the Interior, Bureau of Land Management or by a decree of a Court of Law and/or that the corner points mentioned in lines 3, 4 and 5 above were in conformance with the rules of the Michigan Board of Land Surveyors or by a Decree of a Court of Law; established, re-established, monumented, recovered, found as expressed below:

NOTE: Not more than 2 corners, all in the same town and range, may be recorded on this certificate.

	A	B	C	D	E	F	G	H	I	J	K	L	M
1													
2	6		5		4		3		2		1		
3													
4	7		8		9		10		11		12		
5													
6	18		17		16		15		14		13		
7													
8	19		20		21		22		23		24		
9													
10	30		29		28		27		26		25		
11													
12	31		32		33		34		35		36		
13													

A. Description of original monument and accessories and/or subsequent restoration:

WOOD POST SET BY J. WAMPLER IN 1822, NO EVIDENCE OF ORIGINAL CORNER REMAINS  
LCRC BY JOHN MARTIN IN 1974, L 2, PG 241  
LCRC BY JOHN RAUSER IN 1999, UNKNOWN L & PG  
RECORDED SURVEY L 1892, PG 35


SURVEY &  
RE  
MAR 9 2000  
SECTION

B. Description of corner evidence found and/or method applied in restoring or reestablishing corner:

FOUND 3/4" PIPE IN MONUMENT BOX. VERIFIED WITNESSES FROM LCRC'S. VERIFIED LOCATION WITH DISTANCES TO ADJOINING SECTION CORNERS FROM RECORDED AND UN-RECORDED SURVEYS.

C. Description of monument for corner and accessories established to perpetuate locating the position of the corner:

ACCEPTED BY PEER GROUP AS THE BEST AVAILABLE EVIDENCE OF THE POSITION OF THE ORIGINAL CORNER  
SET 5/8" REBAR W/ 3" BRASS CAP IN MONUMENT BOX  
N45W 43.45' TOP CTR HYDRANT  
S45W 33.29' X IN CONC HDWL  
S20W 49.58' PK NAIL E FCE PWR POLE  
N45E 42.53' PK NAIL NW FCE PWR POLE

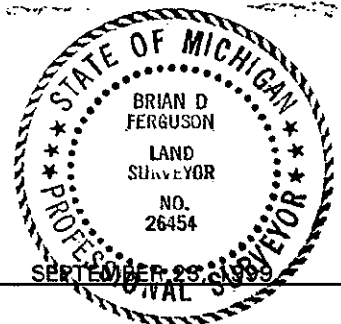

Signed by Brian D Ferguson  
Surveyor's Michigan License No. 26454

Date \_\_\_\_\_