

APPROVED BY PEER GROUP
P.A. 345 OF 1990
SAGINAW COUNTY

9-22-00

SAGINAW COUNTY REMONUMENTATION

LAND CORNER RECORDATION CERTIFICATE
Filing Requirement of Act 74, Mich. P.A. 1970

RECORDED/FILED

1999 SEP 29 A 8:06

MILDRED M. DODAK
REGISTER OF DEEDS
SAGINAW COUNTY, MI.

LIBER 2144 PAGE 768

Lib 8 Page 33

Register of Deeds Stamp & File Number

For corners in

SAGINAW
(County)

KOCHVILLE TOWNSHIP

Located in:

Corner Code #

- | | | |
|------------------------------------|----------------------------|------------|
| 1. Public Land Survey | T <u>13</u> N R <u>4</u> E | <u>1-8</u> |
| | T _____ R _____ | _____ |
| 2. Property Controlling in Section | S _____ T _____ R _____ | _____ |
| | S _____ T _____ R _____ | _____ |
| 3. Miscellaneous Property in Sec. | S _____ T _____ R _____ | _____ |
| | S _____ T _____ R _____ | _____ |

4. Lot No. _____, Recorded Plat _____
5. Private Claims _____

I, Brian D Ferguson, in a field survey on JUNE 30, 19 99 do hereby state that under requirements of P.A. 74, Michigan P.A. of 1970, the corner points mentioned in lines 1 and 2 above were in conformance with regulations and rules therefore as required in the current manual of survey instructions of the United States Department of the Interior, Bureau of Land Management or by a decree of a Court of Law and/or that the corner points mentioned in lines 3, 4 and 5 above were in conformance with the rules of the Michigan Board of Land Surveyors or by a Decree of a Court of Law; established, re-established, monumented, recovered, found as expressed below:

NOTE: Not more than 2 corners, all in the same town and range, may be recorded on this certificate.

1	A	B	C	D	E	F	G	H	I	J	K	L	M
2	8		5		4		3		2				
3													
4	7		8		9		10		11		12		
5													
6	18		17		16		15		14		13		
7													
8	19		20		21		22		23		24		
9													
10	30		29		28		27		26		25		
11													
12	31		32		33		34		35		36		
13													

A. Description of original monument and accessories and/or subsequent restoration:

WOOD POST SET BY J. WAMPLER IN 1822, NO EVIDENCE OF ORIGINAL CORNER REMAINS
LCRC BY JACK ERICKSON IN 1981, L 5, PG 127
SURVEY RECORDED IN L 1480, PG 44


RECORDED &
INDEXED
MAR 9 2000
SECTION

B. Description of corner evidence found and/or method applied in restoring or reestablishing corner:

FOUND ROD IN MONUMENT BOX. VERIFIED LOCATION BY DISTANCES TO ADJOINING SECTION CORNERS FROM RECORDED AND UN-RECORDED SURVEYS

C. Description of monument for corner and accessories established to perpetuate locating the position of the corner:
ACCEPTED BY PEER GROUP AS THE BEST AVAILABLE EVIDENCE OF THE POSITION OF THE ORIGINAL CORNER

- SET 5/8" REBAR W/ 3" BRASS CAP IN MONUMENT BOX
- WEST 68.05' NAIL & SHINNER N FCE PWR POLE
- N70E 47.85' REBAR 6" EAST OF DITCH LINE
- S65E 44.62' REBAR 6" EAST OF DITCH LINE
- N50W 43.24' REBAR WEST SIDE OF DITCH

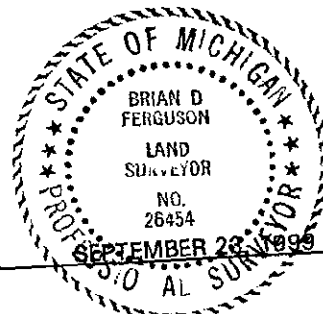

Signed by Brian D Ferguson
Surveyor's Michigan License No. 26454

Date _____