

APPROVED BY PEER GROUP  
P.A. 345 OF 1990  
SAGINAW COUNTY

9-22/BJK

### SAGINAW COUNTY REMONUMENTATION

RECORDED/FILED

### LAND CORNER RECORDATION CERTIFICATE Filing Requirement of Act 74, Mich. P.A. 1970

1999 SEP 29 A 8:06

For corners in

KOCHVILLE TOWNSHIP

<u>SAGINAW</u> (County)	Located in:	Corner Code #
1. Public Land Survey	T <u>13 N</u> R <u>4 E</u>	<u>1-9</u>
	T _____ R _____	_____
2. Property Controlling in Section	S _____ T _____ R _____	_____
	S _____ T _____ R _____	_____
3. Miscellaneous Property in Sec.	S _____ T _____ R _____	_____
	S _____ T _____ R _____	_____

MILDRED M. DODAK  
REGISTER OF DEEDS  
SAGINAW COUNTY, MI.

LIBER 2144 PAGE 769


*Lib 8 Page 34*

Register of Deeds Stamp & File Number

- 4. Lot No. \_\_\_\_\_, Recorded Plat \_\_\_\_\_
- 5. Private Claims \_\_\_\_\_

I, Brian D Ferguson, in a field survey on JUNE 28, 19 99 do hereby state that under requirements of P.A. 74, Michigan P.A. of 1970, the corner points mentioned in lines 1 and 2 above were in conformance with regulations and rules therefore as required in the current manual of survey instructions of the United States Department of the Interior, Bureau of Land Management or by a decree of a Court of Law and/or that the corner points mentioned in lines 3, 4 and 5 above were in conformance with the rules of the Michigan Board of Land Surveyors or by a Decree of a Court of Law; established, re-established, monumented, recovered, found as expressed below:

NOTE: Not more than 2 corners, all in the same town and range, may be recorded on this certificate.

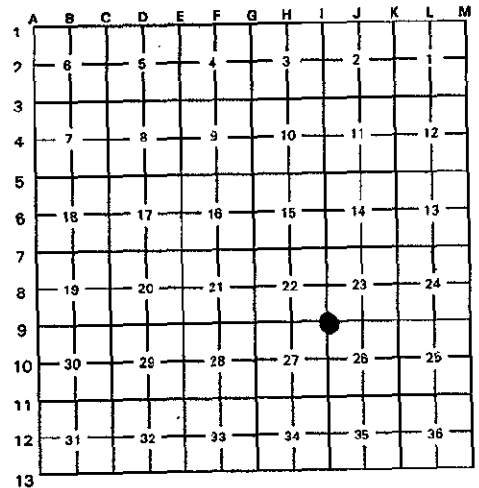

A. Description of original monument and accessories and/or subsequent restoration:

WOOD POST SET BY J. WAMPLER IN 1822, NO EVIDENCE OF ORIGINAL CORNER REMAINS  
LCRC BY RON PREVOST IN 1979, L 5, PG 17  
LCRC BY JOHN RAUSER IN 1999, UNKNOWN L & PG  
RECORDED SURVEY IN L 1676, PG 944

REDFERN &  
REGISTER OF DEEDS

MAR 9 2000

SECTION

B. Description of corner evidence found and/or method applied in restoring or reestablishing corner:

FOUND 3/8" ROD IN MONUMENT BOX PER WITNESSES ON LCRC'S. LOCATION ALSO VERIFIED BY DISTANCES TO ADJOINING SECTION CORNERS FROM RECORDED AND UN-RECORDED SURVEYS

C. Description of monument for corner and accessories established to perpetuate locating the position of the corner:

- ACCEPTED BY PEER GROUP AS THE BEST AVAILABLE EVIDENCE OF THE POSITION OF THE ORIGINAL CORNER
- SET 5/8" REBAR W/ 3" BRASS CAP IN MONUMENT BOX
- N45W 55.13' FCE PWR POLE
- S45W 42.80' X IN CONC HDWL
- S45E 46.66' X IN CONC HDWL
- N55E 41.90' CTR OF MANHOLE IN ROAD

Signed by Brian D Ferguson  
Surveyor's/Michigan License No. 26454

Date \_\_\_\_\_

