

9-1 BDF

SAGINAW COUNTY REMONUMENTATION

LAND CORNER RECORDATION CERTIFICATE
Filing Requirement of Act 74, Mich. P.A. 1970

RECORDED/FILED

1999 SEP 29 A 8:06

MILDRED M. DODAK
REGISTER OF DEEDS
SAGINAW COUNTY, MI.

LIBER 2144 PAGE 770

Liber 8 Page 35

Register of Deeds Stamp & File Number

For corners in

KOCHVILLE TOWNSHIP

Located in: Corner Code #

SAGINAW
(County)

- | | | |
|------------------------------------|-------------------------|-------|
| 1. Public Land Survey | T 13 N R 4 E | I-10 |
| | T _____ R _____ | _____ |
| 2. Property Controlling in Section | S _____ T _____ R _____ | _____ |
| | S _____ T _____ R _____ | _____ |
| 3. Miscellaneous Property in Sec. | S _____ T _____ R _____ | _____ |
| | S _____ T _____ R _____ | _____ |

4. Lot No. _____, Recorded Plat _____
5. Private Claims _____

I, Brian D Ferguson, in a field survey on JUNE 30, 19 99 do hereby state that under requirements of P.A. 74, Michigan P.A. of 1970, the corner points mentioned in lines 1 and 2 above were in conformance with regulations and rules therefore as required in the current manual of survey instructions of the United States Department of the Interior, Bureau of Land Management or by a decree of a Court of Law and/or that the corner points mentioned in lines 3, 4 and 5 above were in conformance with the rules of the Michigan Board of Land Surveyors or by a Decree of a Court of Law; established, re-established, monumented, recovered, found as expressed below:

NOTE: Not more than 2 corners, all in the same town and range, may be recorded on this certificate.

A	B	C	D	E	F	G	H	I	J	K	L	M
2	6	5	4	3	2	1						
3												
4	7	8	9	10	11	12						
5												
6	18	17	16	15	14	13						
7												
8	19	20	21	22	23	24						
9												
10	30	29	28	27	26	25						
11												
12	31	32	33	34	35	36						
13												

A. Description of original monument and accessories and/or subsequent restoration:

WOOD POST SET BY J. WAMPLER IN 1822, NO EVIDENCE OF ORIGINAL CORNER REMAINS
LCRC BY ARTHUR LEACH IN 1974, L 3, PG 60
LCRC BY JOHN RAUSER IN 1999, UNKNOWN L & P
RECORDED SURVEYS IN L 1739, PG 1872 & 2066, PG 1982

RECORDED & FILED

SEP 29 2000

SECTION


B. Description of corner evidence found and/or method applied in restoring or reestablishing corner:

FOUND 3/4" PIPE IN MONUMENT BOX PER WITNESSES ON LCRC'S. VERIFIED LOCATION BY DISTANCES TO ADJOINING SECTION CORNERS FROM RECORDED AND UN-RECORDED SURVEYS.

ACCEPTED BY PEER GROUP AS THE BEST AVAILABLE EVIDENCE OF THE POSITION OF THE ORIGINAL CORNER

C. Description of monument for corner and accessories established to perpetuate locating the position of the corner:

SET 5/8" REBAR W/ 3" BRASS CAP IN MONUMENT BOX
S55E 47.35' NAIL NE FCE PWR POLE
S45E 57.62' TOP CTR HYDRANT
N45E 76.30' SW COR BLDG
WEST 32.70' CTR ST DIR SIGN

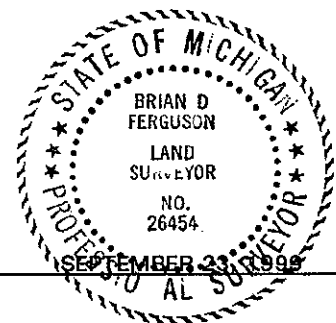

Signed by Brian D Ferguson
Surveyor's Michigan License No. 26454

Date _____