

Saginaw County Remonumentation

LAND CORNER RECORDATION CERTIFICATE  
Filing Requirement of Act 74, Mich. P.A. 1970

*Lib 7 Page 76*

For corners in

Saginaw (County)	Located In:	Corner Code #
Kochville Township	T. 13NR 4E	J-7
1. Public Land Survey	T. R	
	T. R	
	T. R	
	T. R	
2. Property Controlling in Section	S. T. R	
	S. T. R	
3. Miscellaneous Property in Sec.	S. T. R	
	S. T. R	

RECORDED & FILED  
 SEP 27 11 44 AM '96  
 MICHAEL M. DODAK  
 REGISTER OF DEEDS  
 SAGINAW COUNTY MICH.  
 Register of Deeds Stamp & File Number

4. Lot No. \_\_\_\_\_, Recorded Plat \_\_\_\_\_  
5. Private Claims \_\_\_\_\_

I, Michael J. MacDonald, in a field survey on August 20, 1996 do hereby state that under requirements of P.A. 74, Michigan P.A. of 1970, the corner points mentioned in lines 1 and 2 above were in conformance with regulations and rules therefore as required in the current manual of survey instructions of the United States Department of the Interior, Bureau of Land Management or by a decree of a Court of Law and/or that the corner points mentioned in lines 3, 4 and 5 above were in conformance with the rules of the Michigan Board of Land Surveyors or by a Decree of a Court of Law; established, re-established, monumented, recovered, found as expressed below:

1	A	B	C	D	E	F	G	H	I	J	K	L	M
2		6		5		4		3		2		1	
3													
4		7		8		9		10		11		12	
5													
6		10		17		16		15		14		13	
7													
8		19		20		21		22		23		24	
9													
10		30		29		28		27		26		25	
11													
12		31		32		33		34		35		36	
13													

NOTE: Not more than 2 corners, all in the same town and range, may be recorded on this certificate.

A. Description of original monument and accessories and/or subsequent restoration:

J-7 Post set by J. Mullet in 1839.  
Section break by Saginaw County Surveyor, H. Gary in 1879.  
Notes by Redman in 1920 found Oak stake and replaced with City monument.

MDOT witnessed 3/4" pipe in 1969.  
Spicer notes found 3/4" pipe in 1973.  
Recorded Survey - L. 834, P. 484. (Bay County)

B. Description of corner evidence found and/or method applied in restoring or reestablishing corner:


J-7 Found 3/4" pipe 14" long 4' E of 36" diameter concrete culvert.

Recorded Witnesses as follows:  
N 18° E 56.33' (56.9' - R) to face of pole.  
NE 148.24' (148.65' - R) to SE cor Hse. #2494.  
SE 87.67' (87.59' - MDOT) to nail and MDOT tag in pole.  
Monument accepted as best available evidence of the position of the original corner.

C. Description of monument for corner and accessories established to perpetuate locating the position of the corner:

J-7 Replaced 3/4" pipe with Saginaw County Remonumentation cap on 5/8" x 18" rebar in monument box.

S 45° E 87.67' to nail and MDOT tag in NE face of pole.  
N 50° E 148.24' to SE cor of vinyl siding on Hse. #2494.  
N 10° E 56.60' to nail and tag in W side of pole.  
N 80° W 278.00' to nail in S face of transformer pole.

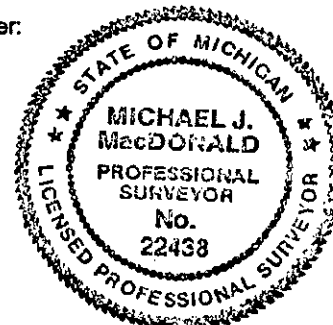

Signed by Michael J. MacDonald  
Surveyor's Michigan License No. 22438

Date 25 Sept 96

REMONUMENTATION

MAY 18 1997

COMMISSION