

APPROVED BY PEER GROUP  
P.A. 345 OF 1990  
SAGINAW COUNTY

*2-21 BDF*

### SAGINAW COUNTY REMONUMENTATION

### LAND CORNER RECORDATION CERTIFICATE Filing Requirement of Act 74, Mich. P.A. 1970

RECORDED/FILED

1999 SEP 29 A 8:07

MILDRED M. DODAK  
REGISTER OF DEEDS  
SAGINAW COUNTY, MI.

LIBER 2144 PAGE 773

*Sheet 8 Page 38*

Register of Deeds Stamp & File Number

For corners in


#### KOCHVILLE TOWNSHIP

<u>SAGINAW</u> (County)	Located in:	Corner Code #
1. Public Land Survey	T <u>13</u> N R <u>4</u> E	<u>J-9</u>
	T _____ R _____	_____
2. Property Controlling in Section	S _____ T _____ R _____	_____
	S _____ T _____ R _____	_____
3. Miscellaneous Property in Sec.	S _____ T _____ R _____	_____
	S _____ T _____ R _____	_____

- 4. Lot No. \_\_\_\_\_, Recorded Plat \_\_\_\_\_
- 5. Private Claims \_\_\_\_\_

I, Brian D Ferguson, in a field survey on JUNE 28, 19 99 do hereby state that under requirements of P.A. 74, Michigan P.A. of 1970, the corner points mentioned in lines 1 and 2 above were in conformance with regulations and rules therefore as required in the current manual of survey instructions of the United States Department of the Interior, Bureau of Land Management or by a decree of a Court of Law and/or that the corner points mentioned in lines 3, 4 and 5 above were in conformance with the rules of the Michigan Board of Land Surveyors or by a Decree of a Court of Law; established, re-established, monumented, recovered, found as expressed below:

NOTE: Not more than 2 corners, all in the same town and range, may be recorded on this certificate.

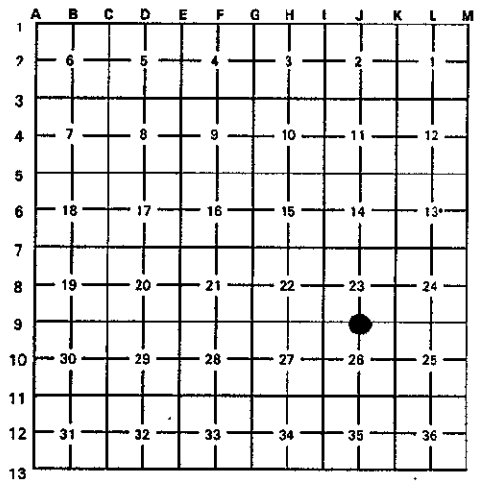

**A. Description of original monument and accessories and/or subsequent restoration:**

WOOD POST SET BY J. WAMPLER IN 1822, NO EVIDENCE OF ORIGINAL CORNER REMAINS  
LCRC BY JACK ERICKSON IN 1981, L 5, PG 128  
LCRC BY JOHN RAUSER IN 1999, UNKNOWN L & PG  
SURVEYS RECORDED IN L 1676, PG 944; 1499, PG 921

SEP 29 2000  
SECTION

**B. Description of corner evidence found and/or method applied in restoring or reestablishing corner:**

FOUND 3/4" PIPE IN MONUMENT BOX PER WITNESSES ON LCRC'S. VERIFIED LOCATION BY DISTANCES TO ADJOINING SECTION CORNERS FROM RECORDED AND UN-RECORDED SURVEYS.

ACCEPTED BY PEER GROUP AS THE BEST AVAILABLE EVIDENCE OF THE POSITION OF THE ORIGINAL CORNER

**C. Description of monument for corner and accessories established to perpetuate locating the position of the corner:**

- SET 5/8" REBAR W/ 3" BRASS CAP IN MONUMENT BOX
- N50E 45.43' NAIL & TAG SE FCE PWR POLE
- S50W 32.65' PK NAIL TOP WOOD POST
- N55W 95.98' NAIL & TAG NE FCE PWR POLE
- S60E 55.25' 1/2" REBAR NORTH DITCH LINE

Signed by *Brian D Ferguson*  
Surveyor's Michigan License No. 26454

Date \_\_\_\_\_