APPROVED BY PEER GROUP
P.A. 345 OF 1990
SAGINAW COUNTY
6-30

SAGINAW COUNTY REMONUMENTATION

LAND CORNER RECORDATION CERTIFICATE

Filing Requirement of Act 74, Mich. P.A. 1970

RECORDED/FILED

1999 SEP 29 A 8 07

MILDRED M. DODAK
REGISTER OF DEEDS
SAGINAW COUNTY, MI.

LIBER 2144 PAGE 776

Liber 8 Page 41

Register of Deeds Stamp & File Number

For corners in

SAGINAW (County) Located in: KOCHVILLE TOWNSHIP Corner Code #

1. Public Land Survey	T13 N R 4 E		K-9
	T____ R____		
2. Property Controlling	S____ T____ R____		
in Section	S____ T____ R____		
3. Miscellaneous	S____ T____ R____		
Property in Sec.	S____ T____ R____		

4. Lot No._____, Recorded Plat_____
5. Private Claims_____

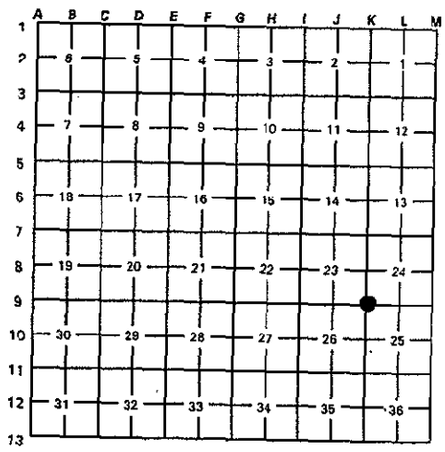

I, Brian D Ferguson, in a field survey on JUNE 28, 19 99 *do hereby* state that under requirements of P.A. 74, Michigan P.A. of 1970, the corner points mentioned in lines 1 and 2 above were in conformance with *regulations and rules therefore* as required in the current manual of survey instructions of the United States Department of the Interior, Bureau of Land Management or by a decree *of a Court of Law* and/or that the corner points mentioned in lines 3, 4 and 5 above were in conformance with the rules of the Michigan Board of Land Surveyors or by a Decree of a Court of Law; established, re-established, monumented, recovered, found as expressed below:

NOTE: Not more than 2 corners, all in the same town and range, may be recorded *on this certificate.*

A. Description of original monument and accessories and/or subsequent *restoration:*

WOOD POST SET BY J. WAMPLER IN 1822, NO EVIDENCE OF ORIGINAL CORNER REMAINS
LCRC BY JOHN MARTIN IN 1973, L 2, PG 111
LCRC BY JACK ERICKSON IN 1981, L 5, PG 126
LCRC BY LLOYD MCGINNIS IN 1976, L 3, PG 199
RECORDED SURVEYS IN L 1427, PG 107; L 1611, PG 1956

RF SURVEY & MAP
MAR 09 2000
SECTION

B. Description of corner evidence found and/or method applied in restoring or reestablishing corner:

FOUND 1" PIPE IN MONUMENT BOX PER WITNESSES ON LCRC'S. VERIFIED LOCTION BY DISTANCES TO ADJOINING CORNRS FROM REOCRDED AND UN-RECORDED SURVEYS

ACCEPTED BY PEER GROUP AS THE BEST AVAILABLE EVIDENCE OF THE POSITION OF THE ORIGINAL CORNER

C. Description of monument for corner and accessories established to perpetuate locating the position of the corner:

SET 5/8" REBAR W/ 3" BRASS CAP IN MONUMENT BOX

N45W	46.30'	NAIL SW FCE PWR POLE
S45W	30.18'	1/2" REBAR 3' OFF SIGN POST
S50E	49.89'	RR SPIKE NW FCE PWR POLE
N45E	48.20'	NAIL SW FCE PWR POLE

STATE OF MICHIGAN
BRIAN D FERGUSON
LAND SURVEYOR
NO. 26454
PROFESSIONAL SURVEYOR

Signed by BD Ferguson

Date SEPTEMBER 28, 1999

Surveyor's Michigan License No. 26454

FORM APPROVED BY MICHIGAN STATE BOARD OF PROFESSIONAL SURVEYORS, JAN. 28, 1971
REVISED MAY 14, 1975
REVISED JAN., 1983
REVISED OCT., ., 1996