

APPROVED BY PEER GROUP  
P.A. 345 OF 1999  
SAGINAW COUNTY

*6-30/2000*

# SAGINAW COUNTY REMONUMENTATION

RECORDED/FILED

## LAND CORNER RECORDATION CERTIFICATE Filing Requirement of Act 74, Mich. P.A. 1970

1999 SEP 29 A 8 07

For corners in

KOCHVILLE TOWNSHIP

SAGINAW  
(County)

Located in:

Corner Code #

1. Public Land Survey

T13 N R 4 E K-10

T \_\_\_\_\_ R \_\_\_\_\_

2. Property Controlling  
in Section

S \_\_\_\_\_ T \_\_\_\_\_ R \_\_\_\_\_

S \_\_\_\_\_ T \_\_\_\_\_ R \_\_\_\_\_

3. Miscellaneous  
Property in Sec.

S \_\_\_\_\_ T \_\_\_\_\_ R \_\_\_\_\_

S \_\_\_\_\_ T \_\_\_\_\_ R \_\_\_\_\_

4. Lot No. \_\_\_\_\_, Recorded Plat \_\_\_\_\_

5. Private Claims \_\_\_\_\_

I, Brian D Ferguson, in a field survey on JUNE 28, 19 99 do hereby state that under requirements of P.A. 74, Michigan P.A. of 1970, the corner points mentioned in lines 1 and 2 above were in conformance with regulations and rules therefore as required in the current manual of survey instructions of the United States Department of the Interior, Bureau of Land Management or by a decree of a Court of Law and/or that the corner points mentioned in lines 3, 4 and 5 above were in conformance with the rules of the Michigan Board of Land Surveyors or by a Decree of a Court of Law; established, re-established, monumented, recovered, found as expressed below:

NOTE: Not more than 2 corners, all in the same town and range, may be recorded on this certificate.

A. Description of original monument and accessories and/or subsequent restoration:

WOOD POST SET BY J. WAMPLER IN 1822, NO EVIDENCE OF ORIGINAL CORNER REMAINS  
LCRC BY JOHN MARTIN IN 1974, L 3, PG 79  
LCRC BY LLOYD MCGINNIS IN 1976, L 3, PG 199  
SURVEYS RECORDED IN LIBER 1427, PG 107; L 1499, PG 921; L 1717, PG 158

B. Description of corner evidence found and/or method applied in restoring or reestablishing corner:



FOUND BOAT SPIKE IN MONUMENT BOX. WITNESSES FROM LCRC'S GONE. VERIFIED LOCATION BY DISTANCES TO ADJOINING CORNRS FROM RECORDED AND UN-RECORDED SURVEYS.

C. Description of monument for corner and accessories established to perpetuate locating the position of the corner:  
ACCEPTED BY PEER GROUP AS THE BEST AVAILABLE EVIDENCE OF THE POSITION OF THE ORIGINAL CORNER

SET 5/8" REBAR W/ 3" BRASS CAP IN MONUMENT BOX  
S45E 43.95' NAIL NW FCE OF PWR POLE  
S45W 42.98' NAIL NE FCE OF PWR POLE  
N45E 79.89' TOP CTR OF HYDRANT  
N45W 51.55' SET REBR

Signed by Brian D Ferguson  
Surveyor's Michigan License No. 26454

Date \_\_\_\_\_

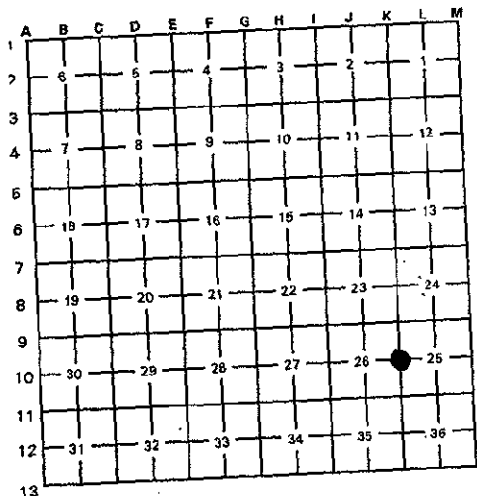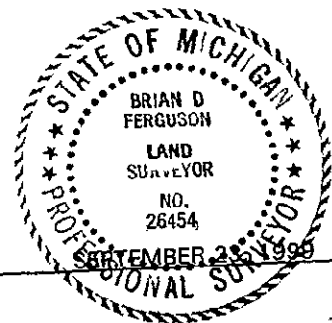

*Lib 8 Page 72*

Register of Deeds Stamp & File Number