

Saginaw County Remonumentation

LAND CORNER RECORDATION CERTIFICATE  
Filing Requirement of Act 74, Mich. P.A. 1970

*Lib 7 Page 75*

For corners in

Saginaw (County)	Located In:	Corner Code #
Kochville Township	T <u>13</u> R <u>4E</u>	<u>L-7</u>
1. Public Land Survey	T ___ R ___	___
	T ___ R ___	___
	T ___ R ___	___
2. Property Controlling in Section	S ___ T ___ R ___	___
	S ___ T ___ R ___	___
3. Miscellaneous Property in Sec.	S ___ T ___ R ___	___
	S ___ T ___ R ___	___

MILDRED H. DODAK  
 REGISTER OF DEEDS  
 SAGINAW COUNTY MICH.  
 SEP 27 11 44 AM '96  
 REGISTERED & FILED  
 Register of Deeds Stamp & File Number

4. Lot No. \_\_\_\_\_, Recorded Plat \_\_\_\_\_  
5. Private Claims \_\_\_\_\_

I, Michael J. MacDonald, in a field survey on August 20, 1996 do hereby state that under requirements of P.A. 74, Michigan P.A. of 1970, the corner points mentioned in lines 1 and 2 above were in conformance with regulations and rules therefore as required in the current manual of survey instructions of the United States Department of the Interior, Bureau of Land Management or by a decree of a Court of Law and /or that the corner points mentioned in lines 3, 4 and 5 above were in conformance with the rules of the Michigan Board of Land Surveyors or by a Decree of a Court of Law; established, re-established, monumented, recovered, found as expressed below:

NOTE: Not more than 2 corners, all in the same town and range, may be recorded on this certificate.

	A	B	C	D	E	F	G	H	I	J	K	L	M
1													
2		6		5		4		3		2		1	
3													
4		7		8		9		10		11		12	
5													
6		10		17		16		15		14		13	
7													
8		19		20		21		22		23		24	
9													
10		30		29		28		27		26		25	
11													
12		31		32		33		34		35		36	
13													

A. Description of original monument and accessories and/or subsequent restoration:

L-7 Post set by J. Mullet in 1839.

L.C.R.C. - L. 4, P. 143 by R. Prevost found 3/4" pipe.  
L. 5, P. 95 by R. Prevost found axle shaft. (Saginaw County)  
Undated Witness Notes by CPCo - old axle.  
Recorded Surveys - L. 1656, P. 891. (Saginaw County)

L.C.R.C. - L. 2, P. 21 by L. McGinnis - pipe.  
(Bay County)  
Recorded Surveys - L. 1159, P. 113;  
L. 1075, P. 493. (Bay County)

B. Description of corner evidence found and/or method applied in restoring or reestablishing corner:


L-7 Found 1" diameter by 30" long axle shaft 8" below surface.  
Also found 3/4" square spike 14" long S 80° W ± 5.21' from axle shaft. Recorded Survey - L. 1656, P. 891 lists spike as L-7.

Recorded Witnesses to axle shaft:  
S 45° E 24.65' ± (24.8' - R)(24.74' - CPCo) to NE cor of concrete headwall.  
S 60° W 33.9' (33.8' - R)(33.76' - CPCo) to NW cor of concrete headwall.  
E 2744.67' (2744.75' - MDOT) to M-7, T13N, R4E.  
Axle shaft accepted as best available evidence of the position of the original corner.

C. Description of monument for corner and accessories established to perpetuate locating the position of the corner:

L-7 Replaced axle shaft with Saginaw County Remonumentation cap on 5/8" x 18" rebar in monument box.

S 55° W 43.42' to nail and tag in W end of 60" CMP.  
N 50° W 29.15' to nail and tag in W end of 24" RCP.  
N 45° E 46.85' to filed notch above steel flap gate on E end of 24" RCP.  
S 55° E 75.66' to nail and tag in N face of 14" Willow.  
S 80° W 5.21' to 3/4" square spike in road 0.15' below chip and seal surface.

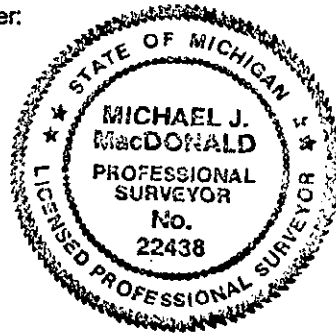

Signed by Michael J. MacDonald  
Surveyor's Michigan License No. 22438

Date 25 Sept 96

REMONUMENTATION

MAY 16 1997

COMMISSION