LAND CORNER RECORDATION CERTIFICATE

Filing Requirement of Act 74, Mich. P.A. 1970

For corners in
SAGINAW
(County)

	Located In:	Corner Code ##
1. Public Land Survey	T 13N R 5E	6-8,6-9
	T ___ R ___	
	T ___ R ___	
	T ___ R ___	
2. Property Controlling	S ___ T ___ R ___	
in Section	S ___ T ___ R ___	
3. Miscellaneous	S 21 T ___ R ___	1096.2, W
Property in Sec.	S ___ T ___ R ___	OF 6-8

Register of Deeds Stamp & File Number

4. Lot No. _____ , Recorded Plat _____
5. Private Claims _____

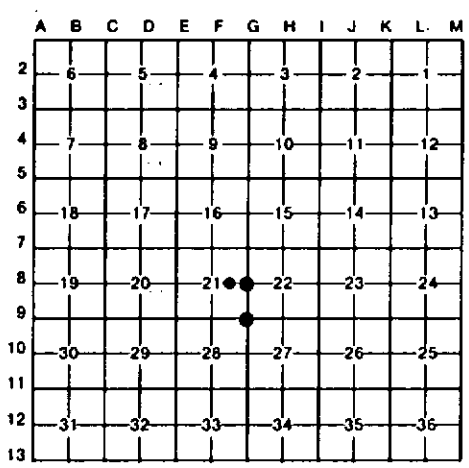

I, C.F.ROSER, in a field survey on DECEMBER 20, 19 91, do hereby certify that under requirements of P.A. 74, Michigan P.A. of 1970, the corner points mentioned in lines 1 and 2 above were in conformance with regulations and rules therefore as required in the current manual of survey instructions of the United States Department of the Interior, Bureau of Land Management or by a decree of a Court of Law and/or that the corner points mentioned in lines 3, 4 and 5 above were in conformance with the rules of the Michigan Board of Land Surveyors or by a Decree of a Court of Law; established, re-established, monumented, re-monumented, recovered, found as expressed below:

NOTE: Not more than 4 corners, all in the same town and range, may be recorded on this certificate.

A. Description of original monument and accessories and/or subsequent restoration:

6-8	6-9	1096.2, W

B. Description of corner evidence found and/or method applied in restoring or reestablishing corner:

6-8	6-9	1096.2, W
FD 3/4" PIPE FOR E 1/4 COR SEC 21. COR FITS PLAT OF "RIVER ROADS FARM SUBDIVISION" BY THOMAS L.K.DONNELLY, 1941. CTR OF OLD E-W DIKE IS SOUTH 14'.	FD BROKEN CONC MON & OTHER PIECES OF IRON FOR NE COR OF SEC 28, IN OPEN FARM FIELD. TOP OF MON WAS 13"± DEEP, DROVE 5/8"x 34" REROD W/LS CAP INSIDE OF CONC MON & LEFT TOP OF REROD 15"± DEEP SO WOULD NOT BE PLOWED OUT.	FD CONC MON AT INTER OF E'LY ROW OF M-13 AND E-W 1/4 LINE OF SEC 21. CTR OF OLD DIKE TO EAST IS SOUTH 12'. CTR OF M-13, IN CURVE, IS 100' WEST. MON FITS 1941 PLAT OF "RIVER ROADS FARMS SUBDIVISION" BY THOMAS L.K. DONNELLY, R.P.E.

C. Description of monument for corner and accessories established to perpetuate locating the position of the corner:

6-8

FD 3/4" BLK IRON PIPE W/CONC BASE.

11"COTTONWOOD	S25°E	7.37'
10"COTTONWOOD	S45°W	14.22'
20"COTTONWOOD	S85°W	20.09'
POWER POLE	S50°W	79.32'
CTR RR TRACKS	EAST	505'
FD 3/4" PIPE	N89°43'E	406.98'

6-9

FD BROKEN CONC MON, ADDED 5/8" REROD W/LS CAP.
CONC RR MARKER POST "SAG6" (4-1/2' TALL TRIANGLE).

	N73°11'E	861.6'
5"ASH	S70°E	632.47'
8"ASH	S50°E	697.64'
CTR RR TRACKS (S. END OF CURVE)	EAST	760.8'

1096.2, W

FD 4" ROUND CONC MON WITH 1/2" SQ IRON ROD IN REMAINS OF TIN CYLINDER.

9" ASH	N15°W	12.94'
10"ASH(CLP-3)	S30°E	2.97'
9" ASH	S75°W	8.56'

STATE OF MICHIGAN
CARL F. ROSER
LAND SURVEYOR
No. 12028
REGISTERED LAND SURVEYOR

Signed by Carl F. Roser 01-10-92 Date _____

Surveyor's Michigan License No. 12028

FORM APPROVED BY MICHIGAN STATE BOARD OF LAND SURVEYORS, JAN. 26, 1971
REVISED MAY 14, 1975
REVISED JAN., 1983