

SURVEY & REMONUMENTATION

MAR 1 2 1999

APPROVED BY PEER GROUP
P.A. 345 OF 1990

LIBER 2084 PAGE 238

SECTION

SAGINAW COUNTY

SAGINAW COUNTY REMONUMENTATION
LAND CORNER RECORDATION CERTIFICATE
Filing Requirement of Act 74, Mich. P.A. 1970

302 9-16-98
For corners in

BUENA VISTA

MILDRED H. DODAK
REGISTER OF DEEDS
SAGINAW COUNTY, MI.

1998 OCT -5 A 9:49

RECORDED/FILED

SAGINAW COUNTY

Located In: ~~MADE~~
Corner Code #

(County)

- 1. Public Land Survey T 13N R 5E J-7
T ___ R ___
T ___ R ___
T ___ R ___
- 2. Property Controlling S ___ T ___ R ___
in Section S ___ T ___ R ___
- 3. Miscellaneous S ___ T ___ R ___
Property in Sec. S ___ T ___ R ___

Lib 7 Page 216

Register of Deeds Stamp & File Number

4. Lot No. _____, Recorded Plat _____

5. Private Claims _____

I, DALE L. WINIECKE, in a field survey on JUNE 2, 1998 do hereby state that under requirements of P.A. 74, Michigan P.A. of 1970, the corner points mentioned in lines 1 and 2 above were in conformance with regulations and rules therefore as required in the current manual of survey instructions of the United States Department of the Interior, Bureau of Land Management or by a decree of a Court of Law and /or that the corner points mentioned in lines 3, 4 and 5 above were in conformance with the rules of the Michigan Board of Land Surveyors or by a Decree of a Court of Law; established, re-established, monumented, recovered, found as expressed below:

	A	B	C	D	E	F	G	H	I	J	K	L	M
1													
2	6		5		4		3		2		1		
3													
4	7		8		9		10		11		12		
5													
6	18		17		16		15		14		13		
7													
8	19		20		21		22		23		24		
9													
10	30		29		28		27		26		25		
11													
12	31		32		33		34		35		36		
13													

NOTE: Not more than 2 corners, all in the same town and range, may be recorded on this certificate.

A. Description of original monument and accessories and/or subsequent restoration:

J-7

- 1. POST SET BY JOHN MULLETT D.S., APRIL 1840. POST SET 40 CHAINS FROM I-6; 10" BLACK OAK, S51°W, 18 LINKS; 10" ELM N10°W, 13 LINKS.
- 2. CERTIFICATE OF SURVEY, L.1366, P. 62, G. DELAMATER, PS#13030, (1971), FOUND 3/4" IRON BAR
- 3. CERTIFICATE OF SURVEY, L.952, P.325, A. LEACH, PS#7235, (1983), FOUND 3/8" REROD
- 4. CERTIFICATE OF SURVEY, L.785, P.539, L. MCGINNIS, PS#18999,(1974), FOUND S 1/4 COR SEC 14, T13N, R5E

B. Description of corner evidence found and/or method applied in restoring or reestablishing corner:


J-7

SEARCHED APPARENT LOCATION OF CORNER AND FOUND A 3/8" REROD 0.15' BELOW ROAD SURFACE. AT 0.80' BELOW ROAD SURFACE FOUND 3/4" PIPE. 3/4" PIPE WAS 0.20' WEST AND 0.15' NORTH OF 3/8" REROD. AT 1.70' BELOW ROAD SURFACE FOUND 1" IRON BAR SURROUNDED BY ROCKS UNDER 3/8" REROD.
CHECKED WITNESSES FROM L. 1366, P.62 SE TO LIGHT POLE 45.75' (R) S 59°E TO NAIL AND TAG IN SOUTHEAST FACE OF LIGHT POLE 49.91'(M); SW TO 18" MAPLE 35.05'(R) SW TO NAIL IN NORTHWEST FACE OF 24" MAPLE 36.17' (M).
CHECKED WITNESSES FROM L. 952, P.325 SW TO NE COR HOUSE 81.50' (R) S 29°W TO NE CORNER OF BLOCK FOUNDATION HOUSE #1755 81.31'(M); SW TO 18" MAPLE 35.1'(R) SW TO NAIL IN NORTHWEST FACE OF 24" MAPLE 36.17' (M).
ACCEPTED 1" BAR AS THE BEST AVAILABLE EVIDENCE OF THE POSITION OF THE ORIGINAL CORNER.

C. Description of monument for corner and accessories established to perpetuate locating the position of the corner:

J-7

SET 5/8" X 24" REROD WITH SAGINAW COUNTY REMONUMENTATION CAP IN MONUMENT BOX OVER FOUND 1" BAR.
SOUTH 5.40' TO CENTERLINE OF MUNGER ROAD.
EAST 2.90' TO CENTERLINE SCHURMAN ROAD
N 61°E 79.55' SET NAIL AND TAG IN SOUTH FACE OF U. POLE
S 59°W 49.91' SET NAIL AND TAG SOUTHEAST FACE OF LIGHT POLE
S 29°W 81.31' TO THE NORTHEAST CORNER OF BLOCK FOUNDATION HSE#1755
S 80°W 137.70' TO RAILROAD SPIKE IN NORTH FACE OF U. POLE
N 42°W 26.28' SET CHISELED 'X' ON WEST END 6' CONC. TUBE

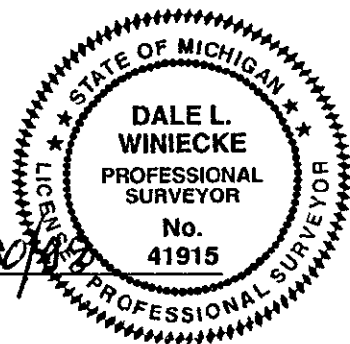

Signed by Dale Winiecke
Surveyor's Michigan License No. 41915

Date 9/30/98