

SAGINAW COUNTY REMONUMENTATION

RECORDED/FILED

LAND CORNER RECORDATION CERTIFICATE
Filing Requirement of Act 74, Mich. P.A. 1970

1997 SEP 26 P 3: 29

For corners in

Saginaw Located In: BUENA VISTA Corner Code #
(County)

1. Public Land Survey T13N R5E M-8
T _____ R _____
T _____ R _____
T _____ R _____

2. Property Controlling S _____ T _____ R _____
in Section S _____ T _____ R _____

3. Miscellaneous S _____ T _____ R _____
Property in Sec. S _____ T _____ R _____

MILDRED H. DODAK
REGISTER OF DEEDS
SAGINAW COUNTY, MI.

LIBER 2027 PAGE 469

Liber 7 Page 160

Register of Deeds Stamp & File Number

4. Lot No. _____, Recorded Plat _____

5. Private Claims _____

I, Michael J. MacDonald, in a field survey on JULY 17, 19 97 do hereby state that under requirements of P.A. 74, Michigan P.A. of 1970, the corner points mentioned in lines 1 and 2 above were in conformance with regulations and rules therefore as required in the current manual of survey instructions of the United States Department of the Interior, Bureau of Land Management or by a decree of a Court of Law and /or that the corner points mentioned in lines 3, 4 and 5 above were in conformance with the rules of the Michigan Board of Land Surveyors or by a Decree of a Court of Law; established, re-established, monumented, recovered, found as expressed below:

NOTE: Not more than 2 corners, all in the same town and range, may be recorded on this certificate.

	A	B	C	D	E	F	G	H	I	J	K	L	M
1													
2	6		5		4		3		2		1		
3													
4	7		8		9		10		11		12		
5													
6	18		17		16		15		14		13		
7													
8	19		20		21		22		23		24		
9													
10	30		29		28		27		26		25		
11													
12	31		32		33		34		35		36		
13													

A. Description of original monument and accessories and/or subsequent restoration:

M-8 SET POST, J. WAMPLER D.S., 1821
ELM 7" N 89 1/2 W, 11 L.
ELM 10" S 34 E, 16 L

1977 L.C.R.C., L.2, P.353, MCGINNIS, FOUND 2" PIPE
1979 SURVEY, L.1579, P. 2151, GOSS, FOUND 2" PIPE

APPROVED BY PEER GROUP
P.A. 345 OF 1990
SAGINAW COUNTY
B-8-97 [Signature]


B. Description of corner evidence found and/or method applied in restoring or reestablishing corner:

M-8 FOUND 1 1/2" BAR. LOCATION VERIFIED FROM WITNESSES (L.C.R.C., L.2, P.353 AND SURVEY, L.1579, P. 2151). MONUMENT ACCEPTED AS THE BEST AVAILABLE EVIDENCE OF THE ORIGINAL CORNER.

C. Description of monument for corner and accessories established to perpetuate locating the position of the corner:

FOUND 1 1/2" SOLID BAR. REPLACED MONUMENT WITH 5/8" x 18" REROD WITH SAGINAW COUNTY REMONUMENTATION MONUMENT BOX.

N 40°E 45.20' SET PK NAIL IN TOP OF CONC. HEADWALL
N 45°E 21.20' SET CAPPED 3/8" REROD
S 25°E 25.64' SET CAPPED 3/8" REROD
S 30°W 21.98' SET CAPPED 3/8" REROD
S 80°W 23.90' CENTERLINE PIPELINE MARKER
N 25°W 18.99' SET CAPPED 3/8" REROD

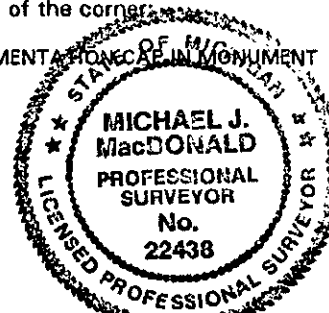

Signed by Michael J. MacDonald

Date 9/25/97

SURVEY &
Surveyor's Michigan Registration 22438

MAR 18 1998

SECTION