

SAGINAW COUNTY REMONUMENTATION

RECORDED/FILED

LAND CORNER RECORDATION CERTIFICATE
Filing Requirement of Act 74, Mich. P.A. 1970

1997 SEP 26 P 3: 29

MILDRED M. DODAK
REGISTER OF DEEDS
SAGINAW COUNTY, MI.

LIBER 2027 PAGE 470

Liber 7 Page 161

Register of Deeds Stamp & File Number

For corners in

Saginaw Located In: BUENA VISTA Corner Code #
(County)

1. Public Land Survey T 13N R 5E Corner Code # M-9
T _____ R _____
T _____ R _____
T _____ R _____

2. Property Controlling S _____ T _____ R _____
in Section S _____ T _____ R _____

3. Miscellaneous S _____ T _____ R _____
Property in Sec. S _____ T _____ R _____

4. Lot No. _____, Recorded Plat _____

5. Private Claims _____

	A	B	C	D	E	F	G	H	I	J	K	L
1												
2	6		5		4		3		2			
3												
4	7		8		9		10		11			
5												
6	18		17		16		15		14			
7												
8	19		20		21		22		23			
9												
10	30		29		28		27		26			
11												
12	31		32		33		34		35			
13												

I, Michael J. MacDonald, in a field survey on SEPTEMBER 9, 1997 do hereby state that under requirements of P.A. 74, Michigan P.A. of 1970, the corner points mentioned in lines 1 and 2 above were in conformance with regulations and rules therefore as required in the current manual of survey instructions of the United States Department of the Interior, Bureau of Land Management or by a decree of a Court of Law and /or that the corner points mentioned in lines 3, 4 and 5 above were in conformance with the rules of the Michigan Board of Land Surveyors or by a Decree of a Court of Law; established, re-established, monumented, recovered, found as expressed below:

NOTE: Not more than 2 corners, all in the same town and range, may be recorded on this certificate.

A. Description of original monument and accessories and/or subsequent restoration:

M-9 SET POST, J. WAMPLER 1821
ASH 16", N 88 1/2° E 10 L.
ASH 18", N 19° W 22 L.

1968 EDMANDS ENGINEERING, CONSUMERS POWER RIGHT OF WAY SURVEY, SET 3/8" REROD
1989 SURVEY, BAY CO. L.1135, P. 271, BURGIN, FND 3/8" REROD
1990 SURVEY, BAY CO. L.1135, P. 285, BURGIN, FND 3/8" REROD
1991 BAY CO. L.C.R.C. L.2, P. 658, BURGIN, FND 3/8" REROD

APPROVED BY PEER GROUP
P.A. 345 OF 1990
SAGINAW COUNTY
9-18-97 *[Signature]*


B. Description of corner evidence found and/or method applied in restoring or reestablishing corner:

M-9 FOUND 3/8" REROD PER RECORDED WITNESSES(BAY CO. L.1135, P. 271; BAY CO. L.1135, P. 285; L.2, P. 658). ALSO FOUND 3/8" REROD 51.94' SOUTH USED IN SURVEY L. 1579, P.2151 AND IN SAGINAW COUNTY ROAD COMMISSION WITNESSES. THE 3/8" REROD TO THE NORTH WAS ACCEPTED AS THE BEST AVAILABLE EVIDENCE OF THE ORIGINAL CORNER.

C. Description of monument for corner and accessories established to perpetuate locating the position of the corner:

M-9 FOUND 3/8" REROD AT WEST EDGE OF ROAD. REPLACED MONUMENT WITH 5/8" REROD WITH SAGINAW COUNTY REMONUMENTATION CAP IN MONUMENT BOX.

N 75° E 41.87' SET NAIL AND TAG IN WEST FACE U.P.
S 60° E 62.62' SET NAIL AND TAG IN SW FACE U.P.
SOUTH 51.94' FOUND 3/8" REROD
S 25° W 25.64' SET NAIL AND TAG IN TOP OF HEADWALL
N 40° W 78.22' TOP CENTERLINE PIPELINE MARKER
N 80° W 41.29' TOP CENTERLINE PIPELINE MARKER
N 70° W 29.04' SET NAIL AND TAG IN NORTH FACE U.P.

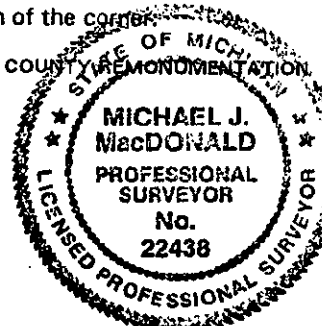

Signed by Michael J. MacDonald Date 9/25/97

Surveyor's Michigan License No. 22438
REMONUMENTATION

MAR 18 1998

SECTION