

SAGINAW COUNTY REMONUMENTATION
LAND CORNER RECORDATION CERTIFICATE
 Filing Requirement of Act 74, Mich. P.A. 1970

RECORDED/FILED

1997 SEP 26 P 3:29

MILDRED M. DODAK
 REGISTER OF DEEDS
 SAGINAW COUNTY, MI.

LIBER 2027 PAGE 471

Liber 7 Page 162

Register of Deeds Stamp & File Number

For corners in

Saginaw
 (County)

Located In: BUENA VISTA

Corner Code #

1. Public Land Survey	T <u>13</u> N R <u>5</u> E	<u>M-10</u>
	T ___ R ___	_____
	T ___ R ___	_____
	T ___ R ___	_____
2. Property Controlling in Section	S ___ T ___ R ___	_____
	S ___ T ___ R ___	_____
3. Miscellaneous Property in Sec.	S ___ T ___ R ___	_____
	S ___ T ___ R ___	_____

4. Lot No. _____, Recorded Plat _____

5. Private Claims _____

I, Michael J. MacDonald, in a field survey on SEPTEMBER 16, 1997 do hereby state that under requirements of P.A. 74, Michigan P.A. of 1970, the corner points mentioned in lines 1 and 2 above were in conformance with regulations and rules therefore as required in the current manual of survey instructions of the United States Department of the Interior, Bureau of Land Management or by a decree of a Court of Law and /or that the corner points mentioned in lines 3, 4 and 5 above were in conformance with the rules of the Michigan Board of Land Surveyors or by a Decree of a Court of Law; established, re-established, monumented, recovered, found as expressed below:

NOTE: Not more than 2 corners, all in the same town and range, may be recorded on this certificate.

1	A	B	C	D	E	F	G	H	I	J	K	L	M
2		6		5		4		3		2		1	
3													
4		7		8		9		10		11		12	
5													
6		18		17		16		15		14		13	
7													
8		19		20		21		22		23		24	
9													
10		30		29		28		27		26		25	
11													
12		31		32		33		34		35		36	
13													

A. Description of original monument and accessories and/or subsequent restoration:

M-10 SET POST, J. WAMPLER D.S. 1821
 ASH 8", N 80° E 2 L.
 ASH 8", N 30° E 5 L.

1968, EDMANDS ENGINEERING, CONSUMERS POWER RIGHT OF WAY SURVEY, SET 3/8" REROD
 1980, SURVEY, L.1585, P.719, MACDONALD, FOUND 3/8" REROD
 1988, SURVEY, L.1734, P.676, MCGINNIS, FOUND 3/8" REROD

APPROVED BY PEER GROUP
 P.A. 345 OF 1990
 SAGINAW COUNTY
9-18-97 *[Signature]*


B. Description of corner evidence found and/or method applied in restoring or reestablishing corner:

M-10 RESET CORNER USING SINGLE PROPORTIONAL MEASUREMENT BETWEEN M-9 AND M-11. SINGLE PROPORTION MEASUREMENT WAS USED IN THE 1968 EDMANDS ENGINEERING CONSUMERS POWER RIGHT OF WAY SURVEY. THE HALF MILE DISTANCE IN THE 1968 SURVEY WAS 2633.50' AND THE HALF MILE DISTANCE USED FOR REMONUMENTATION IS 2633.87'. THIS CORNER WAS ACCEPTED AS THE BEST AVAILABLE EVIDENCE FOR THE POSITION OF THE ORIGINAL CORNER. ALSO FOUND IN THE AREA WAS A 3/8" REROD 53.91' S 85° E OF THE RESET CORNER. THIS CORNER WAS USED IN BAY CO. SURVEY L.1135, P. 271 AND BAY CO. SURVEY, L.1135, P. 285. ANOTHER 3/8" REROD WAS FOUND 35° E 116.34' FROM THE RESET CORNER. THIS CORNER WAS NOT USED IN ANY RECORDED INFORMATION.

C. Description of monument for corner and accessories established to perpetuate locating the position of the corner:

SET 5/8" x 18" REROD WITH SAGINAW COUNTY REMONUMENTATION CAP 20" BELOW THE SURFACE OF FARM FIELD

S 85° E 53.91' FOUND 3/8" REROD 4' EAST OF PHY. CENTERLINE OF JONES ROAD
 S 35° E 116.34' FOUND 3/8" REROD
 S 15° E 102.68' CENTERLINE OF PIPELINE MARKER
 S 4° W 221.00' NE CORNER OF TOWER LEG
 S 18° W 219.91' NW CORNER OF TOWER LEG

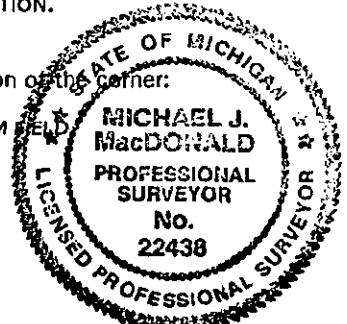

Signed by Michael J. MacDonald

Date 9/25/97

Surveyor's Michigan License No. 22438
 SURVEY &
 REMONUMENTATION

MAR 18 1998

SECTION