

APR 14 1998

LIBER 2 PAGE 171

RECEIVED FOR RECORD

REMONUMENTATION SECTION

LAND CORNER RECORDATION CERTIFICATE
Filing Requirement of Act 74, Mich. P.A. 1970

97 DEC -2 AM 9:10

LIBER NO. 2 PAGE NO. 171
ESTHER LEE
REGISTER OF DEEDS
SANILAC CO., MICHIGAN

For corners in MAPLE VALLEY TOWNSHIP

Sanilac (County)	Located In:	Corner Code #
1. Public Land Survey	T9N R13E	I - 12
	T___ R___	_____
	T___ R___	_____
	T___ R___	_____
2. Property Controlling in Section	S___ T___ R___	_____
	S___ T___ R___	_____
3. Miscellaneous Property in Sec.	S___ T___ R___	_____
	S___ T___ R___	_____

Register of Deeds Stamp & File Number

4. Lot No. _____, Recorded Plat _____
5. Private Claims _____

I, John A Milletics in a field survey on June 28, 1997 do hereby state that under requirements of P.A. 74, Michigan P.A. of 1970, the corner points mentioned in lines 1 and 2 above were in conformance with regulations and rules therefore as required in the current manual of survey instructions of the United States Department of the Interior, Bureau of Land Management or by a decree of a Court of Law and/or that the corner points mentioned in lines 3, 4 and 5 above were in conformance with the rules of the Michigan Board of Land Surveyors or by a Decree of a Court of Law; established, re-established, monumented, recovered, found as expressed below:

NOTE: Not more than 2 corners, all in the same town and range, may be recorded on this certificate.

	A	B	C	D	E	F	G	H	I	J	K	L	M
1													
2	6		5		4		3		2		1		
3													
4	7		8		9		10		11		12		
5													
6	18		17		16		15		14		13		
7													
8	19		20		21		22		23		24		
9													
10	30		29		28		27		26		25		
11													
12	31		32		33		34		35		36		
13													

A. Description of original monument and accessories and/or subsequent restoration:

I - 12

GLO Notes

Set 1/4 Section Post

Beech 11 N63°E 5 1/2

Maple 20 N53°W 26

Old Survey Liber 1886 Survey

by F.F. Rogers

Survey Act 132 Liber 3 Page 187

Unrecorded survey

SURVEY & REMONUMENTATION

B. Description of corner evidence found and/or method applied in restoring or reestablishing corner:

I - 12

W 1/4 Cor Section 35

Found Monu Box with 5/8" Pin in Place
in paved surface.

JAN 08 1998

COMMISSION

APPROVED PEER BOARD MEETING
NOV. 26, 1997

C. Description of monument for corner and accessories established to perpetuate locating the position of the corner:

I - 12

W 1/4 Corner Section 35 T9N-R13E

Monu Box with 5/8" iron in Place

N60°E 38.90 feet to a Stop Sign

S60°E 66.05 feet to a nail in a Power Pole


West 19.40 feet to the North Leg of a Road Sign

S80°W 19.60 feet to the South Leg of a Road Sign

S40°W 73.15 feet to a nail in a 10" Poplar

North 2632.32 feet to the NW Cor Section 35

South 2629.40 feet to the SW Cor Section 35

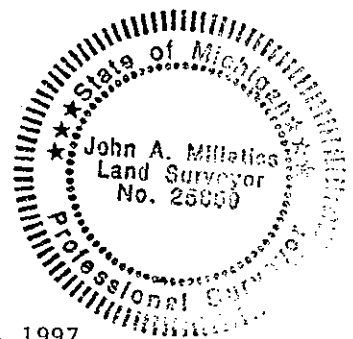

Signed by John A Milletics
Surveyor's Michigan License No. 25859

Date Nov 11, 1997