

SURVEY & REMONUMENTATION

APR 14 1998

LIBER 2 PAGE 170

RECEIVED FOR RECORD

97 DEC -2 AM 9:10

LIBER NO. 2 PAGE NO. 170
ESTHER LEE
REGISTER OF DEEDS
SANILAC CO., MICHIGAN

SECTION REMONUMENTATION

LAND CORNER RECORDATION CERTIFICATE
Filing Requirement of Act 74, Mich. P.A. 1970

For corners in MAPLE VALLEY TOWNSHIP

Sanilac (County)	Located In:	Corner Code #
1. Public Land Survey	T 9N R13E	I - 13
	T R	
	T R	
	T R	
	T R	
2. Property Controlling in Section	S T R	
	S T R	
3. Miscellaneous Property in Sec.	S T R	
	S T R	

Register of Deeds Stamp & File Number

4. Lot No. _____, Recorded Plat _____
5. Private Claims _____

I, John A Milletics, in a field survey on June 28, 1997 do hereby state that under requirements of P.A. 74, Michigan P.A. of 1970, the corner points mentioned in lines 1 and 2 above were in conformance with regulations and rules therefore as required in the current manual of survey instructions of the United States Department of the Interior, Bureau of Land Management or by a decree of a Court of Law and /or that the corner points mentioned in lines 3, 4 and 5 above were in conformance with the rules of the Michigan Board of Land Surveyors or by a Decree of a Court of Law; established, re-established, monumented, recovered, found as expressed below:

NOTE: Not more than 2 corners, all in the same town and range, may be recorded on this certificate.

	A	B	C	D	E	F	G	H	I	J	K	L	M
1													
2		6		5		4		3		2		1	
3													
4		7		8		9		10		11		12	
5													
6		18		17		16		15		14		13	
7													
8		19		20		21		22		23		24	
9													
10		30		29		28		27		26		25	
11													
12		31		32		33		34		35		36	
13													

A. Description of original monument and accessories and/or subsequent restoration:

I - 13
 GLO Notes
 Set Corner Post
 Beech 11 N78°W 10
 Beech 12 N45°E 15

Old Survey Liber 1886 Survey
 by F.F. Rogers
 Unrecorded Survey 1996

COMMISSION
REMONUMENTATION

B. Description of corner evidence found and/or method applied in restoring or reestablishing corner:


I - 13
 Found "T" Bar 45.00 feet West of Road Centerline but in line with road centerline to North.

JAN 08 1998
COMMISSION

APPROVED PEER BOARD MEETING
NOV. 26, 1997

C. Description of monument for corner and accessories established to perpetuate locating the position of the corner:

I - 13
 SW Corner Section 35 T9N-R13E
 "T" Bar with cap
 East 45.00 feet to a PK Nail in centerline of Pavement
 East 78.05 feet to a 1/2" Iron Bar with cap
 West 13.50 feet to a nail in a Fence Post
 N75E 97.72 feet to a nail in a Power Pole
 S05W 16.80 feet to a nail in a Fence Post
 North 2629.40 feet to the W 1/4 Cor Section 35

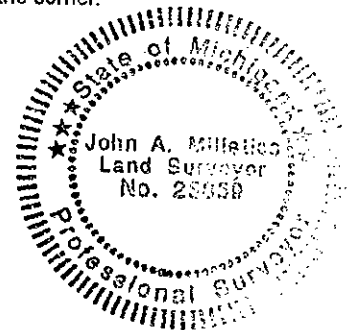

Signed by John A. Milletics
 Surveyor's Michigan License No. 25859

Date Nov 11, 1997