

APR 14 1998

SECTION REMONUMENTATION

LIBER

2 PAGE 167

RECEIVED FOR RECORD

LAND CORNER RECORDATION CERTIFICATE Filing Requirement of Act 74, Mich. P.A. 1970

97 DEC -2 AM 9:10

LIBER NO. 2 PAGE NO. 167 ESTHER LEE REGISTER OF DEEDS SANILAC CO. MICHIGAN

For corners in SPEAKER TOWNSHIP

Table with columns: Sanilac (County), Located in, Corner Code #. Rows include Public Land Survey, Property Controlling in Section, and Miscellaneous Property in Sec.

Register of Deeds Stamp & File Number

4. Lot No. , Recorded Plat
5. Private Claims

I, John A Milletics, in a field survey on June 28, 19 97 do hereby state that under requirements of P.A. 74, Michigan P.A. of 1970, the corner points mentioned in lines 1 and 2 above were in conformance with regulations and rules therefore as required in the current manual of survey instructions of the United States Department of the Interior, Bureau of Land Management or by a decree of a Court of Law and/or that the corner points mentioned in lines 3, 4 and 5 above were in conformance with the rules of the Michigan Board of Land Surveyors or by a Decree of a Court of Law; established, re-established, monumented, recovered, found as expressed below:

Grid table with columns A-M and rows 1-13. A dot is marked at row 6, column C.

NOTE: Not more than 2 corners, all in the same town and range, may be recorded on this certificate.

A. Description of original monument and accessories and/or subsequent restoration:

C - 6
GLO Notes
Set 1/4 Section Post
B.Ash 29 N25°E 10 1/2
Elm 01 S14°W 11

No recording in old survey liber
Unrecorded survey dated 11-22-88
showing section break down
No Act 74, No act 132

B. Description of corner evidence found and/or method applied in restoring or reestablishing corner:

C - 6
Found R/R Spike in blacktop surface
as shown on above survey

STATE OF MICHIGAN REMONUMENTATION


JAN 08 1998

COMMISSION

APPROVED PEER BOARD MEETING
NOV. 26, 1997

C. Description of monument for corner and accessories established to perpetuate locating the position of the corner:

C - 6
E 1/4 Corner Section 18 T9N-R14E Speaker Twp.
Monu Box with iron and cap
N85°W 48.49 feet to a nail in a Tele Pole
N80°E 79.00 feet to a nail in a Power Pole
S45°W 60.87 feet to the south end of a 12" CMP
South 1318.00 to a P.K. Nail in blacktop
South 2636.00 to the SE Cor Section 18
S45°E 74.66 feet to the south end of a 12" CMP
North 2632.58 feet to the NE Cor Section 18

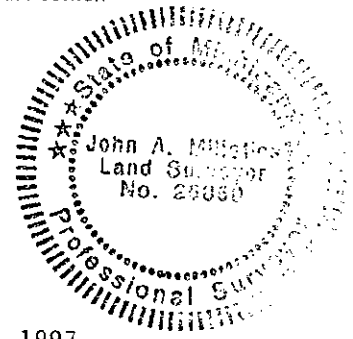

Signed by [Signature]
Surveyor's Michigan License No. 25859

Date NOV 12, 1997