

SURVEY & REMONUMENTATION

APR 14 1998

LIBER 2 PAGE 166

RECEIVED FOR RECORD

97 DEC -2 AM 9:09

SECTION REMONUMENTATION

LAND CORNER RECORDATION CERTIFICATE
Filing Requirement of Act 74, Mich. P.A. 1970

LIBER NO. 2 PAGE NO. 166
ESTHER LEE
REGISTER OF DEEDS
SANILAC CO., MICHIGAN

For corners in SPEAKER TOWNSHIP

<u>Sanilac</u> (County)	Located In:	Corner Code #
1. Public Land Survey	T <u>9</u> N R <u>14</u> E	<u>C - 7</u>
	T <u> </u> R <u> </u>	<u> </u>
	T <u> </u> R <u> </u>	<u> </u>
	T <u> </u> R <u> </u>	<u> </u>
2. Property Controlling in Section	S <u> </u> T <u> </u> R <u> </u>	<u> </u>
	S <u> </u> T <u> </u> R <u> </u>	<u> </u>
3. Miscellaneous Property in Sec.	S <u> </u> T <u> </u> R <u> </u>	<u> </u>
	S <u> </u> T <u> </u> R <u> </u>	<u> </u>

Register of Deeds Stamp & File Number

4. Lot No. _____, Recorded Plat _____
5. Private Claims _____

I, John A Milletics, in a field survey on June 28, 1997 do hereby state that under requirements of P.A. 74, Michigan P.A. of 1970, the corner points mentioned in lines 1 and 2 above were in conformance with regulations and rules therefore as required in the current manual of survey instructions of the United States Department of the Interior, Bureau of Land Management or by a decree of a Court of Law and/or that the corner points mentioned in lines 3, 4 and 5 above were in conformance with the rules of the Michigan Board of Land Surveyors or by a Decree of a Court of Law, established, re-established, monumented, recovered, found as expressed below:

NOTE: Not more than 2 corners, all in the same town and range, may be recorded on this certificate.

	A	B	C	D	E	F	G	H	I	J	K	L	M
1													
2	6		5		4		3		2		1		
3													
4	7		8		9		10		11		12		
5													
6	18		17		16		15		14		13		
7													
8	19		20		21		22		23		24		
9													
10	30		29		28		27		26		25		
11													
12	31		32		33		34		35		36		
13													

A. Description of original monument and accessories and/or subsequent restoration:

C - 7

GLO Notes

Set Post Corner
Birch 20 N91½E 36
Birch 15 S35½W 46

Old Survey Liber, March 1890 survey
by Galbraith
Section break down unrecorded survey
dated 1-8-97

SUB BY
REMONUMENTATION

B. Description of corner evidence found and/or method applied in restoring or reestablishing corner:

C - 7

Found 3/4" iron bar 6" deep in paved surface

JAN 08 1998


COMMISSION

APPROVED PEER BOARD MEETING
NOV. 26, 1997 JA

C. Description of monument for corner and accessories established to perpetuate locating the position of the corner:

C - 7

NE Cor Section 19 T9N-R14E Speaker Twp.
Monu Box with iron and cap
N85°W 18.55 feet to the south leg of a road sign
West 50.00 feet to a 1/2" iron with cap
N45°E 95.55 feet to a Nail in a Power Pole
N70°E 50.73 feet to a Stop Sign
N30°W 128.49 feet to a nail in a Tele Pole
South 2630.22 feet to the E 1/4 Corner Section 19
North 2636.00 feet to the E 1/4 Corner Section 18

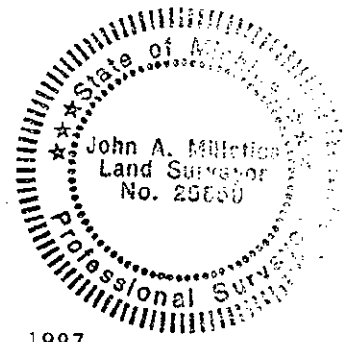

Signed by John A. Milletics
Surveyor's Michigan License No. 25859

Date Nov 12, 1997