

NOV 1 9 1993 LAND CORNER RECORDATION CERTIFICATE

COMMISSION FILING REQUIREMENT OF ACT 74, MICH. P.A.1970

FOR CORNERS OF--:	LOCATED IN--:	CORNER CODE NUMBER
1. PUBLIC LAND SURVEY _____	T. <u>10</u> N. <input checked="" type="checkbox"/> , R. <u>12</u> E. <input checked="" type="checkbox"/>	<u>G - 1</u>
2. PROPERTY CONTROLLING IN SECTION _____	T. _____, S. _____, R. _____, E. _____	
3. MISCELLANEOUS PROPERTY IN SECTION _____	T. _____, S. _____, R. _____, E. _____	
4. LOT NO. _____, RECORDED PLAT _____		
5. PRIVATE CLAIMS _____		

RECEIVED FOR RECORD

93 NOV -4 AM 11:55

LIBER 1 PAGE NO. 381
ESTHER LEE
REGISTER OF DEEDS
SANILAC CO., MICHIGAN

REGISTER OF DEEDS STAMP AND FILING NUMBER

I, John A Milletics, do hereby certify that under requirements of P.A. 74, Michigan P.A. of 1970, the corner points mentioned in lines 1 and 2 above were, in a field survey on July 5, 1993, established, re-established, monumented, re-monumented, recovered or restored as expressed below and in conformance with regulations and rules therefore as required in the current manual of survey instructions of the United States Department of the Interior, Bureau of Land Management or by a decree of a court of law. Furthermore, that the corner points mentioned in lines 3, 4 and 5 above were, in a field survey on _____, 19____, found, recovered, restored, established or re-established as expressed below and in conformance with the rules of the Michigan State Board of Registration for Land Surveyors or, by a Decree of a Court of law:

A. Description of original monument and accessories and/or subsequent restoration:

G - 1 Found P.K. nail under two layers of blacktop matching old records from the Sanilac County Road Comm.

F - 1 Found R/R Spike in Blacktop as recorded in Liber 2 Page 504 of the Sanilac County Records.

B. Description of corner evidence found and/or method applied in restoring or re-establishing corner:

G - 1
NE Cor Section 4 T10N-R12E
Found P.K. nail

F - 1
N 1/4 Cor Section 4 T10N-R12E
Found R/R spike

C. Description of monument for corner and accessories established to perpetuate locating the position of the corner:

G - 1
NE Cor Section 4 T10N-R12E
Monu Box set
North 18.85' to the West leg Arrow Sign
S45°W 57.70' to a nail in a Power Pole
S45°E 56.60' to a nail in a Telephone Pole

F - 1
N 1/4 Cor Section 4 T10N-R12E
Monu Box set
N30°W 42.50' to the Arrow on a fire Hydrant
S45°W 37.60' to the nail in a 18" Maple
South 31.60' to the nail in a 30" Maple

Distance between G - 1, F - 1 measures 2671.34 feet

SIGNED BY [Signature] DATE Nov 1, 1993

SURVEYOR'S MICHIGAN REGISTRATION NO. 25859


FOR STATE AND UNITED STATES AGENCIES:

SIGNED BY _____ DATE _____

CHIEF OF SURVEY PARTY

APPROVED AND SIGNED BY _____ DATE _____

MICHIGAN REGISTERED LAND SURVEYOR

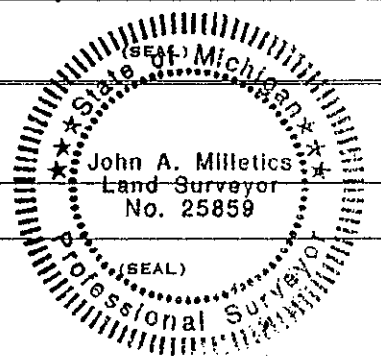

SURVEYOR'S MICHIGAN REGISTRATION NO. _____