

NOV 21 1997

LIBER

PAGE 119

COMMISSION

REMONUMENTATION

LAND CORNER RECORDATION CERTIFICATE
Filing Requirement of Act 74, Mich. P.A. 1970

RECEIVED FOR RECORD

97 SEP -9 AM 8:56

LIBER NO. 2 PAGE NO. 119

ESTHER LEE
REGISTER OF DEEDS
SANILAC CO. MICHIGAN

For corners in

<u>Sanilac</u> (County)	Located In:	Corner Code #
1. Public Land Survey	T10N R12E	B - 1
	T R	
	T R	Seg. 2
	T R	
2. Property Controlling in Section	S T R	
	S T R	
3. Miscellaneous Property in Sec.	S T R	
	S T R	

Register of Deeds Stamp & File Number

4. Lot No. _____, Recorded Plat _____
5. Private Claims _____

I, John A Milletics, in a field survey on May 21, 1997 do hereby state that under requirements of P.A. 74, Michigan P.A. of 1970, the corner points mentioned in lines 1 and 2 above were in conformance with regulations and rules therefore as required in the current manual of survey instructions of the United States Department of the Interior, Bureau of Land Management or by a decree of a Court of Law and/or that the corner points mentioned in lines 3, 4 and 5 above were in conformance with the rules of the Michigan Board of Land Surveyors or by a Decree of a Court of Law; established, re-established, monumented, recovered, found as expressed below:

NOTE: Not more than 2 corners, all in the same town and range, may be recorded on this certificate.

	A	B	C	D	E	F	G	H	I	J	K	L	M
1													
2	6		5		4		3		2		1		
3													
4	7		8		9		10		11		12		
5													
6	18		17		16		15		14		13		
7													
8	19		20		21		22		23		24		
9													
10	30		29		28		27		26		25		
11													
12	31		32		33		34		35		36		
13													

A. Description of original monument and accessories and/or subsequent restoration:

GLO NOTES
No GLO's Available


APPROVED PEER BOARD MEETING
Aug 18, 1997 JM

B. Description of corner evidence found and/or method applied in restoring or reestablishing corner:

B - 1
N 1/4 Cor Section 6 T10N-R12E
Found Monu Box - removed by Sanilac County Road Comm. during reconstruction of Road - REPLACED using Act 74 recorded Liber 1 Page 387

C. Description of monument for corner and accessories established to perpetuate locating the position of the corner:

B - 1
N 1/4 Corner Section 6 T10N-R12E
Moun Box with iron and cap
South 55.00 feet to a 1/2" Iron Bar
South 31.30 feet to a nail in a Tele Pole
N05°E 55.20 feet to a nail in a Fence Post
S30°E 60.75 feet to a nail in a Fence Post
N50°E 59.80 feet to a nail in a 12" Ash
N10°W 39.00 feet to a nail in a 10" Ash
East 2659.00' to the NE Cor. Section 6
West 2829.72' to the NW Cor. Section 6

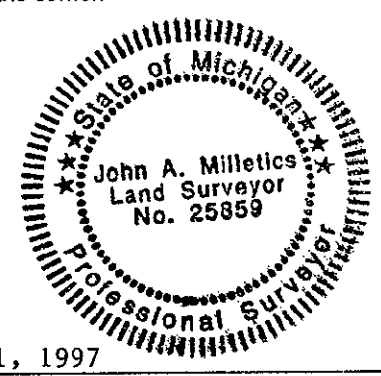

Signed by John A. Milletics
Surveyor's Michigan License No. 25859

Date Aug 11, 1997