

REMONUMENTATION

NOV 21 1997

COMMISSION

LIBER 2 PAGE 120

REMONUMENTATION
LAND CORNER RECORDATION CERTIFICATE
Filing Requirement of Act 74, Mich. P.A. 1970

RECEIVED FOR RECORD

97 SEP -9 AM 8:56

LIBER NO. 2 PAGE NO. 120

ESTHER LEE
REGISTER OF DEEDS
SANILAC CO., MICHIGAN

For corners in

Sanilac
(County)

Located In:

Corner Code #

1. Public Land Survey

T10N R12E C-1

T R

T R

T R

2. Property Controlling in Section

S T R

S T R

3. Miscellaneous Property in Sec.

S T R

S T R

Register of Deeds Stamp & File Number

4. Lot No. , Recorded Plat

5. Private Claims

I, John A Milletics, in a field survey on May 21, 1997 do hereby state that under requirements of P.A. 74, Michigan P.A. of 1970, the corner points mentioned in lines 1 and 2 above were in conformance with regulations and rules therefore as required in the current manual of survey instructions of the United States Department of the Interior, Bureau of Land Management or by a decree of a Court of Law and for that the corner points mentioned in lines 3, 4 and 5 above were in conformance with the rules of the Michigan Board of Land Surveyors or by a Decree of a Court of Law; established, re-established, monumented, recovered, found as expressed below:

NOTE: Not more than 2 corners, all in the same town and range, may be recorded on this certificate.

1	A	B	C	D	E	F	G	H	I	J	K	L	M
2		6		5		4		3		2		1	
3													
4		7		8		9		10		11		12	
5													
6		18		17		16		15		14		13	
7													
8		19		20		21		22		23		24	
9													
10		30		29		28		27		26		25	
11													
12		31		32		33		34		35		36	
13													

A. Description of original monument and accessories and/or subsequent restoration:

C - 1

GLO Notes

Cedar 8 S25°E 23

Cedar 12 S43°W 25

APPROVED PEER BOARD MEETING

Aug 18, 1997 JPM

B. Description of corner evidence found and/or method applied in restoring or reestablishing corner:

C - 1

NE Corner Section 6

Found Monu Box - removed by Sanilac County Road Comm. during reconstruction of Road - REPLACED using Act 74 as recorded in Liber 1 Page 387

C. Description of monument for corner and accessories established to perpetuate locating the position of the corner:

C - 1

NE Corner Section 6 T10N-R12E

Monu Box with iron and cap

S60°E 61.15 feet to a nail in a Power Pole


N05°W 23.00 feet to the West Leg of a Road Sign

N05°E 22.95 feet to the East Leg of a Road Sign

N45°E 73.20 feet to a nail in a Power Pole

S35°E 39.05 feet to a Stop Sign

West 2659.00' to the N 1/4 Cor Section 6

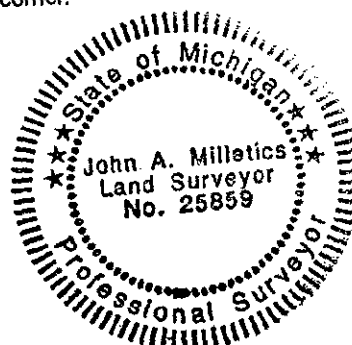

Signed by J.A. Milletics

Surveyor's Michigan License No. 25859

Date Aug 11, 1997