

RECEIVED FOR RECORD

94 DEC 16 AM 9:41

LAND CORNER RECORDATION CERTIFICATE
Filing Requirement of Act 74, Mich. P.A. 1970

REMONUMENTATION

For corners in

Sanilac

LIBER NO. 2 PAGE NO. 18
ESTHER LEE
REGISTER OF DEEDS
SANILAC CO., MICHIGAN

	Located In:	Corner Code #
1. Public Land Survey	T 10N R 13 E	A - 7
	T _____ R _____	_____
	T _____ R _____	_____
	T _____ R _____	_____
2. Property Controlling in Section	S _____ T _____ R _____	_____
	S _____ T _____ R _____	_____
3. Miscellaneous Property in Sec.	S _____ T _____ R _____	_____
	S _____ T _____ R _____	_____

Register of Deeds Stamp & File Number

4. Lot No. _____, Recorded Plat _____
5. Private Claims _____

I, John A Milletics, in a field survey on Dec 1, 19 94, do hereby certify that under requirements of P.A. 74, Michigan P.A. of 1970, the corner points mentioned in lines 1 and 2 above were in conformance with regulations and rules therefore as required in the current manual of survey instructions of the United States Department of the Interior, Bureau of Land Management or by a decree of a Court of Law and/or that the corner points mentioned in lines 3, 4 and 5 above were in conformance with the rules of the Michigan Board of Land Surveyors or by a Decree of a Court of Law; established, re-established, monumented, re-monumented, recovered, found as expressed below:

NOTE: Not more than 4 corners, all in the same town and range, may be recorded on this certificate.

A. Description of original monument and accessories and/or subsequent restoration:
A - 7 GLO Notes
Set Post Maple 8 N14W 48, Elm 11 S71W 62

Act 74 Form L 1 Page 159 Swartz

Act 132 Forms Liber 3, Page 18, Liber 3, Page 460, Liber 3, Page 18 and 19

B. Description of corner evidence found and/or method applied in restoring or reestablishing corner:
A - 7 NW Cor Section 19 T10N-R13E


Found 1/2" Iron in Place

C. Description of monument for corner and accessories established to perpetuate locating the position of the corner:

A - 7
NW Cor Section 19 T10N-R13E
Found 1/2 " Iron bar
N70°W 124.66' to a nail 36" Ash
N18°19'W 48.19' to a nail in a 4" Apple
West 2621.58' to N 1/4 Cor Section 24 T10N-R12E
S67°27'W 93.47' to a nail 8" Aspen

	A	B	C	D	E	F	G	H	I	J	K	L	M
2	6	5	4	3	2	1							
3													
4	7	8	9	10	11	12							
5													
6	18	17	16	15	14	13							
7													
8	19	20	21	22	23	24							
9													
10	30	29	28	27	26	25							
11													
12	31	32	33	34	35	36							
13													

Approved Peer Board Meeting
Dec. 16, 1994 *gn*

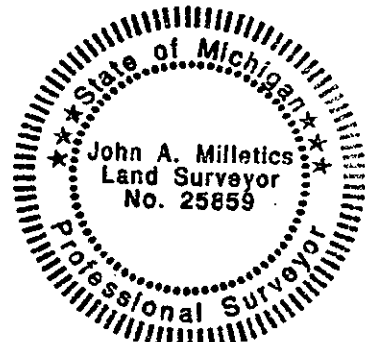

Signed by John A. Milletics Date Dec 5, 1994
Surveyor's Michigan License No. 25859