

Remonumentation

LAND CORNER RECORDATION CERTIFICATE
Filing Requirement of Act 74, Mich. P.A. 1970

RECEIVED FOR RECORD

95 JUL 10 AM 9: 26

LIBER NO. 2 PAGE NO. 52

ESTHER LEE
REGISTER OF DEEDS
SANILAC CO., MICHIGAN

For corners in Sanilac (County)

Located In:

Corner Code #

Table with 3 columns: Item description, Located In (T, S), and Corner Code (#). Includes items like Public Land Survey, Property Controlling in Section, and Miscellaneous Property in Sec.

Register of Deeds Stamp & File Number

4. Lot No. , Recorded Plat
5. Private Claims

I, John A Milletics, in a field survey on April 10, 1995, do hereby certify that under requirements of P.A. 74, Michigan P.A. of 1970, the corner points mentioned in lines 1 and 2 above were in conformance with regulations and rules therefore as required in the current manual of survey instructions of the United States Department of the Interior, Bureau of Land Management or by a decree of a Court of Law and/or that the corner points mentioned in lines 3, 4 and 5 above were in conformance with the rules of the Michigan Board of Land Surveyors or by a Decree of a Court of Law; established, re-established, monumented, re-monumented, recovered, found as expressed below:

NOTE: Not more than 4 corners, all in the same town and range, may be recorded on this certificate.

A. Description of original monument and accessories and/or subsequent restoration:

F-5 GLO Notes

Set Post at 39.98 Chains Hemloch 8 S56 1/2 E 37, Hemloch 24 N20 E 17
Act 74 Form None Act 132 Form Liber 3 Page 623, Old Survey Liber Page 44 April 1903

G-5 GLO Notes


Set Post Beech 20 N66E 16, Pine 24 S57W 39.
Old Survey Liber Page 44 April 1903, Act 74 Form None, Act 132 Form None

Approved Peer Group Meeting May 25, 1995

B. Description of corner evidence found and/or method applied in restoring or reestablishing corner:

F-5
S 1/4 Cor Section 9 T10N-R13E
Found 5/8" iron bar in gravel road bed

G-5
SE Cor Section 9 T10N-R13E
Found 1/2" Iron Bar in gravel Road Bed

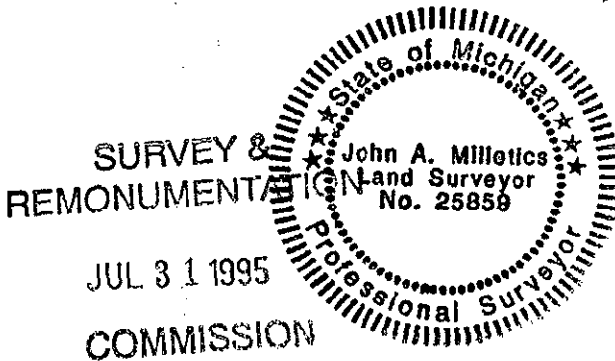

C. Description of monument for corner and accessories established to perpetuate locating the position of the corner:

F-5
S 1/4 Cor Section 9 T10N-R13E
5/8" Iron bar
North 48.3 to the east leg of a Road Sign
N40 W 35.2 to a nail in a Fence/Post
S35 E 51.9 to a Stop Sign
S30 W 83.1 to a Cable Post Sign

G-5
SE Cor Section 9 T10N-R13E
Found 1/2" Iron Bar
South 19.2 to the west leg of a Road Sign
S10 W 115.9 to a nail in a 24" Ash
S45 W 78.0 to a bolt in a Power Pole
N45 E 68.2 to a nail in a Tele Pole

Signed by [Signature]

Date May 21 1995

Surveyor's Michigan License No. 25859