

NOV 21 1997

LIBER 2 PAGE 145

COMMISSION

REMONUMENTATION

LAND CORNER RECORDATION CERTIFICATE
Filing Requirement of Act 74, Mich. P.A. 1970

RECEIVED FOR RECORD

97 SEP -9 AM 8:58

LIBER NO. 2 PAGE NO. 145

ESTHER LEE
REGISTER OF DEEDS
SANILAC CO., MICHIGAN

For corners in

Sanilac

(County)

Located In:

Corner Code #

1. Public Land Survey

T 10N R 13E

H - 1

T R

T R

T R

T R

leg 2

2. Property Controlling in Section

S T R

S T R

3. Miscellaneous Property in Sec.

S T R

S T R

4. Lot No. , Recorded Plat

5. Private Claims

Register of Deeds Stamp & File Number

I, John A Milletics, in a field survey on June 21, 1997 do hereby state that under requirements of P.A. 74, Michigan P.A. of 1970, the corner points mentioned in lines 1 and 2 above were in conformance with regulations and rules therefore as required in the current manual of survey instructions of the United States Department of the Interior, Bureau of Land Management or by a decree of a Court of Law and /or that the corner points mentioned in lines 3, 4 and 5 above were in conformance with the rules of the Michigan Board of Land Surveyors or by a Decree of a Court of Law; established, re-established, monumented, recovered, found as expressed below:

NOTE: Not more than 2 corners, all in the same town and range, may be recorded on this certificate.

	A	B	C	D	E	F	G	H	I	J	K	L	M
1													
2	6			5			4		3		2		1
3													
4	7			8			9		10		11		12
5													
6	18			17			16		15		14		13
7													
8	19			20			21		22		23		24
9													
10	30			29			28		27		26		25
11													
12	31			32			33		34		35		36
13													

A. Description of original monument and accessories and/or subsequent restoration:

H - 1

NO GLO Notes Available

APPROVED PEER BOARD MEETING

Aug 18, 1997 gm

B. Description of corner evidence found and/or method applied in restoring or reestablishing corner:


H - 1

Found Monu Box - removed by Sanilac Co. Road Comm. during reconstruction of Road, REPLACED using Act 74 recording Liber 1 Page 423

C. Description of monument for corner and accessories established to perpetuate locating the position of the corner:

H - 1

N 1/4 Cor Section 3 T10N-R13E
Monu Box Set with iron & cap
East 34.48 to the S 1/4 Corner Section 33 (Monu Box)
East 2639.06 to the SE Cor Section 3
West 2639.06 to the SW Cor Section 3
N40°E 38.00 to the North End of a 36" CMP
S40°E 39.00 to the South End of a 36" CMP

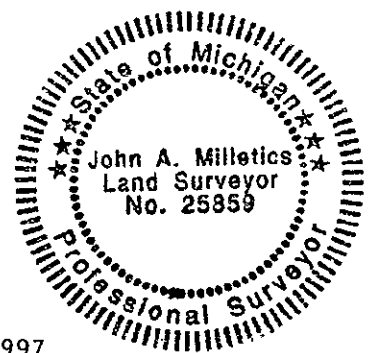

Signed by [Signature]
Surveyor's Michigan License No. 25859

Date Aug 11, 1997