

REMONUMENTATION

NOV 21 1997

COMMISSION

LIBER 2 PAGE 136

REMONUMENTATION
LAND CORNER RECORDATION CERTIFICATE
Filing Requirement of Act 74, Mich. P.A. 1970

RECEIVED FOR RECORD

97 SEP -9 AM 8:57

LIBER NO. 2 PAGE NO. 136
ESTHER LEE
REGISTER OF DEEDS
SANILAC CO., MICHIGAN

For corners in

Sanilac (County)	Located In:	Corner Code #
1. Public Land Survey	T 10N R 13E	J - 13
	T R	
	T R	
	T R	
	T R	
2. Property Controlling in Section	S T R	
	S T R	
3. Miscellaneous Property in Sec.	S T R	
	S T R	

Register of Deeds Stamp & File Number

- 4. Lot No. _____, Recorded Plat _____
- 5. Private Claims _____

	A	B	C	D	E	F	G	H	I	J	K	L	M
1													
2	6	5	4	3	2	1							
3													
4	7	8	9	10	11	12							
5													
6	18	17	16	15	14	13							
7													
8	19	20	21	22	23	24							
9													
10	30	29	28	27	26	25							
11													
12	31	32	33	34	35	36							
13													

I, John A Milletics, in a field survey on Aug 11, 1997 do hereby state that under requirements of P.A. 74, Michigan P.A. of 1970, the corner points mentioned in lines 1 and 2 above were in conformance with regulations and rules therefore as required in the current manual of survey instructions of the United States Department of the Interior, Bureau of Land Management or by a decree of a Court of Law and/or that the corner points mentioned in lines 3, 4 and 5 above were in conformance with the rules of the Michigan Board of Land Surveyors or by a Decree of a Court of Law; established, re-established, monumented, recovered, found as expressed below:

NOTE: Not more than 2 corners, all in the same town and range, may be recorded on this certificate.

A. Description of original monument and accessories and/or subsequent restoration:

- J - 13
- GLO Notes
- Elm 24 N73°E 30
- Pine 24 N71W 18


APPROVED PEER BOARD MEETING
Aug 18, 1997 *JM*

B. Description of corner evidence found and/or method applied in restoring or reestablishing corner:

- J - 13
- S 1/4 Corner Section 35 T11N-R13E
- Found Monu Box in Place - removed by the Sanilac County Road Comm. during reconstruction of road - REPLACED using Act 74 as recorded in Liber 1 Page 407

C. Description of monument for corner and accessories established to perpetuate locating the position of the corner:

- J - 13
- S 1/4 Corner Section 35 T11N-R13E
- MONU BOX with iron and cap
- N45°W 47.50 feet to a nail in a Power Pole
- S45°W 79.00 feet to a Stop Sign
- East 2660.00 to the SE Cor Section 35
- N50°E 47.50 feet to the SW Corner of a Mailbox post
- N01°W 24.80 feet to the top of a CMP

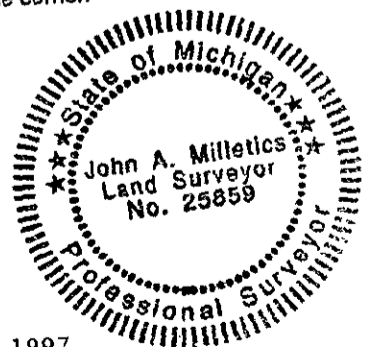

Signed by *John A. Milletics*
Surveyor's Michigan License No. 25859

Date Aug 11, 1997