REMONUMENTATION

LIBER 1 PAGE 475

RECEIVED FOR RECORD
94 AUG 12 PM 2:38
LIBER NO. 1 PAGE NO. 475
ESTHER LEE
REGISTER OF DEEDS
SANILAC CO., MICHIGAN

LAND CORNER RECORDATION CERTIFICATE
Filing Requirement of Act 74, Mich. P.A. 1970

For corners in Sanilac (County)

	Located In:	Corner Code ##
1. Public Land Survey	T 10 N R 13 E	M - 8, M - 9
	T ___ R ___	
	T ___ R ___	
	T ___ R ___	
2. Property Controlling in Section	S ___ T ___ R ___	
	S ___ T ___ R ___	
3. Miscellaneous Property in Sec.	S ___ T ___ R ___	
	S ___ T ___ R ___	

Register of Deeds Stamp & File Number

4. Lot No. _____, Recorded Plat _____
5. Private Claims _____

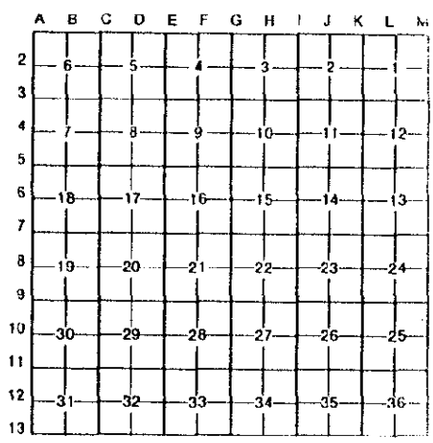

I, John A Milletics, in a field survey on July 7, 19 94, do hereby certify that under requirements of P.A. 74, Michigan P.A. of 1970, the corner points mentioned in lines 1 and 2 above were in conformance with regulations and rules therefore as required in the current manual of survey instructions of the United States Department of the Interior, Bureau of Land Management or by a decree of a Court of Law and/or that the corner points mentioned in lines 3, 4 and 5 above were in conformance with the rules of the Michigan Board of Land Surveyors or by a Decree of a Court of Law; established, re-established, monumented, re-monumented, recovered, found as expressed below:

NOTE: Not more than 4 corners, all in the same town and range, may be recorded on this certificate.

A. Description of original monument and accessories and/or subsequent restoration:

M - 8 Found 5/8" Iron bar, raised with 1/2" iron, in gravel road bed

M - 9 Found 1/2" Iron bar in gravel road bed

Approved Peer Board Meeting
Aug. 9, 1994 RDK
JM

B. Description of corner evidence found and/or method applied in restoring or reestablishing corner:

M - 8
E 1/4 Cor Section 24 T10N- R13E
Found 5/8" iron bar

M - 9
SE Cor Section 24 T10N-R13E
Found 5/8" iron bar

SURVEY &
REMONUMENTATION

SEP 07 1994

COMMISSION

C. Description of monument for corner and accessories established to perpetuate locating the position of the corner:

M - 8
E 1/4 Cor Section 24 T10N-R13E
1/2" iron bar
East 25.30 to a nail S side of a Fence Post
West 66.00 to a nail S side of a Power Pole
N45°W 53.4 to a nail NW side of a 6" Pine
South 2640.76' to the SE of 24

M - 9
SE Cor Section 24 T10N-R13E
1/2" Iron Bar
N40°E 75.20 to a nail SW side of a Power Pole
N45°W 101.0 to a nail SW side of a Power Pole
S50°W 34.40 to a stop sign
N50°W 34.70 to a stop sign
North 2640.76' to the E 1/4 Cor Sec 24

Signed by John A Milletics Date July 23, 1994

Surveyor's Michigan License No. 25859

FORM APPROVED BY MICHIGAN STATE BOARD OF LAND SURVEYORS, JAN. 28, 1971
REVISED MAY 14, 1975
REVISED JAN., 1983