REMONUMENTATION

LIBER 1 PAGE 476

RECEIVED FOR RECORD
94 AUG 12 PM 2:38
LIBER NO. 1 PAGE NO. 476
ESTHER LEE
REGISTER OF DEEDS
SANILAC CO., MICHIGAN

LAND CORNER RECORDATION CERTIFICATE
Filing Requirement of Act 74, Mich. P.A. 1970

For corners in Sanilac (County)

	Located In:	Corner Code #
1. Public Land Survey	T 10 N R 13 E	M - 10, M - 11
	T ___ R ___	
	T ___ R ___	
	T ___ R ___	
2. Property Controlling	S ___ T ___ R ___	
in Section	S ___ T ___ R ___	
3. Miscellaneous	S ___ T ___ R ___	
Property in Sec.	S ___ T ___ R ___	

Register of Deeds Stamp & File Number

4. Lot No. _____, Recorded Plat _____
5. Private Claims _____

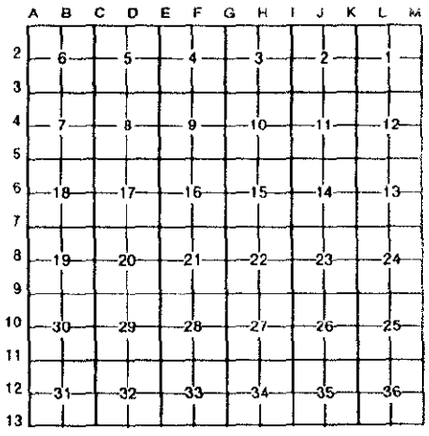

I, John A Milletics, in a field survey on July 7, 19 94, do hereby certify that under requirements of P.A. 74, Michigan P.A. of 1970, the corner points mentioned in lines 1 and 2 above were in conformance with regulations and rules therefore as required in the current manual of survey instructions of the United States Department of the Interior, Bureau of Land Management or by a decree of a Court of Law and/or that the corner points mentioned in lines 3, 4 and 5 above were in conformance with the rules of the Michigan Board of Land Surveyors or by a Decree of a Court of Law; established, re-established, monumented, re-monumented, recovered, found as expressed below:

NOTE: Not more than 4 corners, all in the same town and range, may be recorded on this certificate.

A. Description of original monument and accessories and/or subsequent restoration:

M - 10 Found 5/8" Iron bar in gravel road bed

M - 11 Found 5/8" Iron bar in paved surface

Approved Peer Board Meeting
Aug. 9, 1994

B. Description of corner evidence found and/or method applied in restoring or reestablishing corner:

M - 10
E 1/4 Cor Section 25 T10N-R13E
Found 5/8" Iron Bar

M - 11
SE Cor Section 25 T10N-R13E
Found 5/8" Iron Bar

SURVEY &
REMONUMENTATION
SEP 07 1994
COMMISSION

C. Description of monument for corner and accessories established to perpetuate locating the position of the corner:

M - 10
E 1/4 Cor Section 25 T10N-R13E
5/8" Iron Bar
N80°E 33.00 to a metal fence post
S75°E 33.20 to a metal fence post
N45°E 40.10 to a metal fence post
South 2632.8 to the SE of 25
North 2611.82 to the NE of 25

M - 11
SE Cor Section 25 T10N-R13E
Monu Box
N40°E 60.8 to a nail top of Fence Post
N60°E 89.3 to a nail NW side of Power Pole
N45°W 51.7 to a nail NE side of a Fence Post
S65°W 37.6 to a road sign
North 2632.8 to the E 1/4 Cor Section 25

Signed by John A Milletics Date July 23 1994
Surveyor's Michigan License No. 25859

FORM APPROVED BY MICHIGAN STATE BOARD OF LAND SURVEYORS, JAN. 28, 1971
REVISED MAY 14, 1975
REVISED JAN., 1983