

NOV 21 1997

LIBER

2 PAGE 123

COMMISSION

REMONUMENTATION
LAND CORNER RECORDATION CERTIFICATE
Filing Requirement of Act 74, Mich. P.A. 1970

RECEIVED FOR RECORD

97 SEP -9 AM 8:56

LIBER NO. 2 PAGE NO. 123
ESTHER LEE
REGISTER OF DEEDS
SANILAC CO. MICHIGAN

For corners in

Sanilac (County)	Located In:	Corner Code #
1. Public Land Survey	T10N R14E	B - 1
	T__ R__	_____
	T__ R__	_____
	T__ R__	_____
	T__ R__	_____
2. Property Controlling in Section	S__ T__ R__	_____
	S__ T__ R__	_____
3. Miscellaneous Property in Sec.	S__ T__ R__	_____
	S__ T__ R__	_____

Register of Deeds Stamp & File Number

4. Lot No. _____, Recorded Plat _____
5. Private Claims _____

I, John A Milletics, in a field survey on June 21, 19 97 do hereby state that under requirements of P.A. 74, Michigan P.A. of 1970, the corner points mentioned in lines 1 and 2 above were in conformance with regulations and rules therefore as required in the current manual of survey instructions of the United States Department of the Interior, Bureau of Land Management or by a decree of a Court of Law and /or that the corner points mentioned in lines 3, 4 and 5 above were in conformance with the rules of the Michigan Board of Land Surveyors or by a Decree of a Court of Law; established, re-established, monumented, recovered, found as expressed below:

NOTE: Not more than 2 corners, all in the same town and range, may be recorded on this certificate.

	A	B	C	D	E	F	G	H	I	J	K	L	M
1													
2	6		5		4		3		2		1		
3													
4	7		8		9		10		11		12		
5													
6	18		17		16		15		14		13		
7													
8	19		20		21		22		23		24		
9													
10	30		29		28		27		26		25		
11													
12	31		32		33		34		35		36		
13													

A. Description of original monument and accessories and/or subsequent restoration:

B - 1
GLO Notes Not Availible

APPROVED PEER BOARD MEETING


Aug 18, 1997 JM

B. Description of corner evidence found and/or method applied in restoring or reestablishing corner:

B - 1
Found Monu Box - removed by Sanilac County Road Comm, during reconstruction of Road, REPLACED using Act 74 recorded in Liber 1 Page 426

C. Description of monument for corner and accessories established to perpetuate locating the position of the corner:

B - 1
N 1/4 Corner Section 6 T10N-R14E
Monu Box with iron and cap
West 972.06 to the NW Cor Section 6 (MONU BOX)
N50°W 110.55 to a nail in a Power Pole
S20°E 21.40 to the East end of a 12" CMP
S10°W 55.61 to a nail in a 6" Poplar
S15°W 55.25 to a nail in a 8" Poplar
East 2640.0 to the NE Cor Section 6

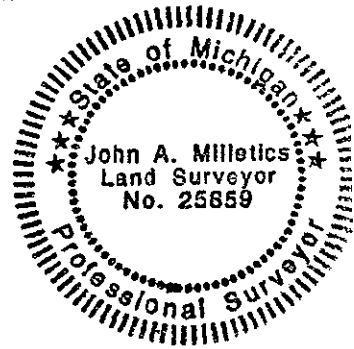

Signed by [Signature]
Surveyor's Michigan License No. 25859

Date Aug 11, 1997