

APR 14 1998

SECTION  
REMONUMENTATION

LIBER 2 PAGE 159

LAND CORNER RECORDATION CERTIFICATE  
Filing Requirement of Act 74, Mich. P.A. 1970

RECEIVED FOR RECORD

97 DEC -2 AM 9:09

LIBER NO. 2 PAGE NO. 159  
ESTHER LEE  
REGISTER OF DEEDS  
SANILAC CO., MICHIGAN

For corners in ELK TOWNSHIP

Sanilac (County)	Located In:	Corner Code #
1. Public Land Survey	T 10N R 14E	D - 11
	T R	
	T R	
	T R	
2. Property Controlling in Section	S T R	
	S T R	
3. Miscellaneous Property in Sec.	S T R	
	S T R	

REMONUMENTATED

JAN 08 1998

Register of Deeds Stamp & File Number

4. Lot No. \_\_\_\_\_ . Recorded Plat \_\_\_\_\_  
5. Private Claims \_\_\_\_\_

I, John A Milletics, in a field survey on June 29, 1997 do hereby state that under requirements of P.A. 74, Michigan P.A. of 1970, the corner points mentioned in lines 1 and 2 above were in conformance with regulations and rules therefore as required in the current manual of survey instructions of the United States Department of the Interior, Bureau of Land Management or by a decree of a Court of Law and /or that the corner points mentioned in lines 3, 4 and 5 above were in conformance with the rules of the Michigan Board of Land Surveyors or by a Decree of a Court of Law; established, re-established, monumented, recovered, found as expressed below:

NOTE: Not more than 2 corners, all in the same town and range, may be recorded on this certificate.

	A	B	C	D	E	F	G	H	I	J	K	L	M
1													
2	6		5		4		3		2		1		
3													
4	7		8		9		10		11		12		
5													
6	18		17		16		15		14		13		
7													
8	19		20		21		22		23		24		
9													
10	30		29		28		27		26		25		
11													
12	31		32		33		34		35		36		
13													

A. Description of original monument and accessories and/or subsequent restoration:

D - 11

GLO Notes

Set 1/4 Section Post  
Maple 15 N58°E 18  
Maple 6 S36°W 13

No Old Survey Liber  
No Act 74  
Act 132 Liber 1 Page 423  
Unrecorded survey dated 4-2-91

B. Description of corner evidence found and/or method applied in restoring or reestablishing corner:

D - 11


Found P.K. Nail as previously recorded in surveys

APPROVED PEER BOARD MEETING  
NOV. 26, 1997 *JM*

C. Description of monument for corner and accessories established to perpetuate locating the position of the corner:

D - 11

S 1/4 Corner Section 29 T10N-R14E Elk Twp.  
Moun Box in place with 5/8" Iron Bar  
S45°W 48.75 to a nail in a 18" Pine  
S35°W 96.84 to a nail in a 36" Maple  
N45°W 94.65 to a nail in a Power Pole  
N45°E 56.60 to a nail in a Power Pole  
S30°E 41.90 to a stop sign  
West 2629.88 feet to the SW Corner of Section 29  
East 2632.16 feet to the SE Corner of Section 29

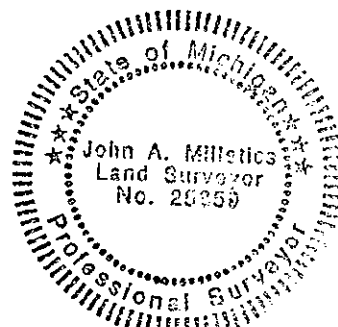

Signed by John A Milletics  
Surveyor's Michigan License No. 25859

Date Nov 12, 1997