

**SURVEY & REMONUMENTATION**

APR 14 1998

**SECTION  
REMONUMENTATION**

LIBER 2 PAGE 158

RECEIVED FOR RECORD

LAND CORNER RECORDATION CERTIFICATE  
Filing Requirement of Act 74, Mich. P.A. 1970

97 DEC -2 AM 9:09

LIBER NO. 2 PAGE NO. 158

ESTHER LEE  
REGISTER OF DEEDS  
SANILAC CO., MICHIGAN

For corners in ELK TOWNSHIP

Sanilac (County)	Located in:	Corner Code #
1. Public Land Survey	T 10N R 14E	E - 11
	T R	
	T R	
	T R	
2. Property Controlling in Section	S T R	
	S T R	
3. Miscellaneous Property in Sec.	S T R	
	S T R	

REMONUMENTATION

JAN 08 1997

COMMISSION

Register of Deeds Stamp & File Number

4. Lot No. \_\_\_\_\_, Recorded Plat \_\_\_\_\_  
5. Private Claims \_\_\_\_\_

I, John A Millettics, in a field survey on June 29, 1997 do hereby state that under requirements of P.A. 74, Michigan P.A. of 1970, the corner points mentioned in lines 1 and 2 above were in conformance with regulations and rules therefore as required in the current manual of survey instructions of the United States Department of the Interior, Bureau of Land Management or by a decree of a Court of Law and for that the corner points mentioned in lines 3, 4 and 5 above were in conformance with the rules of the Michigan Board of Land Surveyors or by a Decree of a Court of Law; established, re-established, monumented, recovered, found as expressed below:

NOTE: Not more than 2 corners, all in the same town and range, may be recorded on this certificate.

	A	B	C	D	E	F	G	H	I	J	K	L	M
1													
2	6		5		4		3		2		1		
3													
4	7		8		9		10		11		12		
5													
6	18		17		16		15		14		13		
7													
8	19		20		21		22		23		24		
9													
10	30		29		28		27		26		25		
11													
12	31		32		33		34		35		36		
13													

A. Description of original monument and accessories and/or subsequent restoration:

E - 11

GLO Notes

Set Post Corner  
Sugar 16 S41°E 40  
Sugar 11 N85°W 20

Old Survey Liber Survey by Nicol Dated April 1907  
Act 74 None  
Act 132 None  
Unrecorded surveys dated 6-25-87, 8-21-91

B. Description of corner evidence found and/or method applied in restoring or reestablishing corner:

E - 11


Found R/R Spike in paved surface as shown on surveys

APPROVED PEER BOARD MEETING  
NOV. 26, 1997

C. Description of monument for corner and accessories established to perpetuate locating the position of the corner:

E - 11

SE Corner Section 29 T10N-R14E Elk Twp.  
Monu Box in place with 1/2" iron bar with cap  
North 48.10 feet to a nail in a Fence Post  
N45°W 45.00 feet to a 1/2" Iron Bar  
N45°E 45.00 feet to a 1/2" Iron Bar  
East 2656.98 feet to the S 1/4 Cor Section 28  
West 2632.16 feet to the S 1/4 Cor Section 29

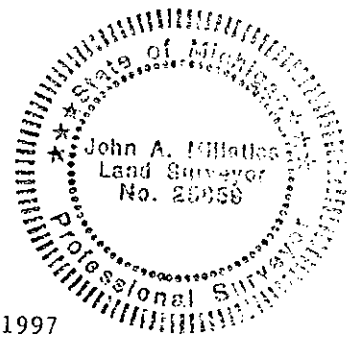

Signed by John A. Millettics  
Surveyor's Michigan License No. 25859

Date Nov 12, 1997