

**SURVEY & REMONUMENTATION**

APR 14 1998

**SECTION REMONUMENTATION**

LIBER 2 PAGE 157

**LAND CORNER RECORDATION CERTIFICATE**  
Filing Requirement of Act 74, Mich. P.A. 1970

For corners in ELK TOWNSHIP

<u>Sanilac</u> (County)	Located In:	Corner Code #
1. Public Land Survey	T <u>10N</u> R <u>14E</u>	<u>F - 11</u>
	T <u>   </u> R <u>   </u>	<u>   </u>
	T <u>   </u> R <u>   </u>	<u>   </u>
2. Property Controlling in Section	S <u>   </u> T <u>   </u> R <u>   </u>	<u>   </u>
	S <u>   </u> T <u>   </u> R <u>   </u>	<u>   </u>
3. Miscellaneous Property in Sec.	S <u>   </u> T <u>   </u> R <u>   </u>	<u>   </u>
	S <u>   </u> T <u>   </u> R <u>   </u>	<u>   </u>

RECEIVED FOR RECORD  
97 DEC -2 AM 9:09  
LIBER NO. 2 PAGE NO. 157  
ESTHER LEE  
REGISTER OF DEEDS  
SANILAC CO., MICHIGAN  
JAN 08 1998  
COMMISSION  
Register of Deeds Stamp & File Number

4. Lot No. \_\_\_\_\_, Recorded Plat \_\_\_\_\_  
5. Private Claims \_\_\_\_\_

I, John A Milletics, in a field survey on June 29, 1997 do hereby state that under requirements of P.A. 74, Michigan P.A. of 1970, the corner points mentioned in lines 1 and 2 above were in conformance with regulations and rules therefore as required in the current manual of survey instructions of the United States Department of the Interior, Bureau of Land Management or by a decree of a Court of Law and/or that the corner points mentioned in lines 3, 4 and 5 above were in conformance with the rules of the Michigan Board of Land Surveyors or by a Decree of a Court of Law; established, re-established, monumented, recovered, found as expressed below:

NOTE: Not more than 2 corners, all in the same town and range, may be recorded on this certificate.

	A	B	C	D	E	F	G	H	I	J	K	L	M
1													
2	6		5		4		3		2		1		
3													
4	7		8		9		10		11		12		
5													
6	18		17		16		15		14		13		
7													
8	19		20		21		22		23		24		
9													
10	30		29		28		27		26		25		
11													
12	31		32		33		34		35		36		
13													

A. Description of original monument and accessories and/or subsequent restoration:

F - 11  
GLO Notes  
Set 1/4 Section Post  
Hemlock 10 N12'E 8  
Beech 8 South 12  
Old Survey Liber Survey dated April 1907  
by Nicol  
Act 74 None  
Act 132 None  
Unrecorded surveys dated 3-9-83, 6-25-87  
9-04-78


B. Description of corner evidence found and/or method applied in restoring or reestablishing corner:

F - 11  
Found R/R Spike in paved surface

APPROVED PEER BOARD MEETING  
NOV. 26, 1997 *gm*

C. Description of monument for corner and accessories established to perpetuate locating the position of the corner:

F - 11  
S 1/4 Corner Section 28 T10N-R14E  
Monu Box in place with 1/2" Iron Bar and cap  
N40°E 55.70 feet to a nail in a Tele Pole  
S45°E 58.90 feet to a nail in a Power Pole  
S35°E 90.40 feet to a nail in a Anchor Pole  
S40°W 75.95 feet to the NW Corner of a Lagre Rock  
N40°W 41.55 feet to a Stop Sign  
West 2656.98 feet to the SW Corner Section 28

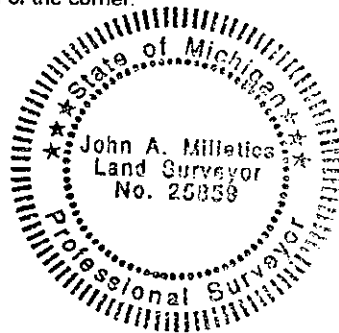

Signed by *John A. Milletics*  
Surveyor's Michigan License No. 25859

Date Nov 12, 1997