LIBER 1 PAGE 490

RECEIVED FOR RECORD

94 DEC 16 AM 9:40

LIBER NO. 1 PAGE NO. 490
ESTHER LEE
REGISTER OF DEEDS
SANILAC CO., MICHIGAN

REMONUMENTATION

LAND CORNER RECORDATION CERTIFICATE
Filing Requirement of Act 74, Mich. P.A. 1970

SURVEY & REMONUMENTATION
APR 10 1995
COMMISSION

For corners in Sanilac (County)

	Located In:	Corner Code #
1. Public Land Survey	T 10N R 14E	F - 13
	T ___ R ___	
	T ___ R ___	
	T ___ R ___	
2. Property Controlling	S ___ T ___ R ___	
in Section	S ___ T ___ R ___	
3. Miscellaneous	S ___ T ___ R ___	
Property in Sec.	S ___ T ___ R ___	

Register of Deeds Stamp & File Number

4. Lot No. _____, Recorded Plat _____
5. Private Claims _____

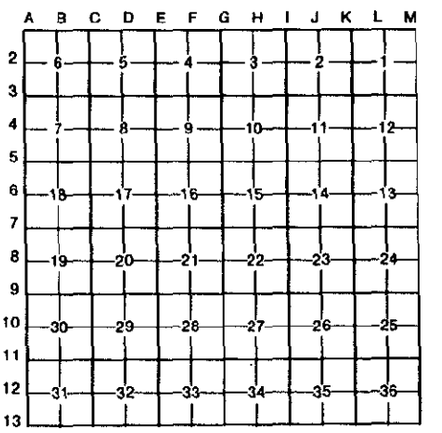

I, John A Milletics, in a field survey on Aug 15, 19 94, do hereby certify that under requirements of P.A. 74, Michigan P.A. of 1970, the corner points mentioned in lines 1 and 2 above were in conformance with regulations and rules therefore as required in the current manual of survey instructions of the United States Department of the Interior, Bureau of Land Management or by a decree of a Court of Law and/or that the corner points mentioned in lines 3, 4 and 5 above were in conformance with the rules of the Michigan Board of Land Surveyors or by a Decree of a Court of Law; established, re-established, monumented, re-monumented, recovered, found as expressed below:

NOTE: Not more than 4 corners, all in the same town and range, may be recorded on this certificate.

A. Description of original monument and accessories and/or subsequent restoration:

F - 13 GLO Notes
Set ½Mile Post Sugar 11 N40E 25, Beech 12 N15W 20

Act 74 Form NONE
Act 132 Form Liber 3 Page 448
Unrecorded Survey Dated 4-20-89

Road Comm NONE
Drain Comm NONE

Approved Peer Board Meeting
Dec. 16, 1994 _____

B. Description of corner evidence found and/or method applied in restoring or reestablishing corner:

F - 13
S 1/4 Cor Section 33 T10N-R14E
Found 1/2" Iron Bar
East 66.80 to a 1/2" Iron Bar in Road Bed(N 1/4 Cor Section 4)
N50°W 54.51 to a nail in a Power Pole
S15°E 59.67 to a nail in a Power Pole
N50°E 55.58 to a nail in a Wooden Fence Post
N45°E 57.70 to a nail in a Tele Pole

C. Description of monument for corner and accessories established to perpetuate locating the position of the corner:

F - 13
S 1/4 Cor Section 33 T10N-R14E
Found 1/2" Iron Bar
East 66.80 to a 1/2" Iron bar in Road Bed(N 1/4 Cor Section 4)
N50°W 54.51 to a nail in a Power Pole
S15°E 59.67 to a nail in a Power Pole
N50°E 55.58 to a nail in a Wooden Fence Post
N45°E 57.70 to a nail in a Tele Pole

State of Michigan
John A. Milletics
Land Surveyor
No. 25859
Professional Surveyor

Signed by _____ Date Dec 8, 1994

Surveyor's Michigan License No. 25859

FORM APPROVED BY MICHIGAN STATE BOARD OF LAND SURVEYORS, JAN. 28, 1971
REVISED MAY 14, 1975
REVISED JAN., 1983