

RECEIVED FOR RECORD

94 DEC 16 AM 9:41

REMONUMENTATION

LAND CORNER RECORDATION CERTIFICATE  
Filing Requirement of Act 74, Mich. P.A. 1970

LIBER NO. 2 PAGE NO. 25  
ESTHER LEE  
REGISTER OF DEEDS  
SANILAC CO., MICHIGAN

For corners in

Sanilac  
(County)

Located In:

Corner Code #

1. Public Land Survey 10N R 14E J-11  
 T      R       
 T      R       
 T      R       
 T      R
2. Property Controlling in Section S      T      R       
 S      T      R
3. Miscellaneous Property in Sec. S      T      R       
 S      T      R
4. Lot No. \_\_\_\_\_, Recorded Plat \_\_\_\_\_
5. Private Claims \_\_\_\_\_

Register of Deeds Stamp & File Number

I, John A Milletics, in a field survey on Aug 16, 19 94, do hereby certify that under requirements of P.A. 74, Michigan P.A. of 1970, the corner points mentioned in lines 1 and 2 above were in conformance with regulations and rules therefore as required in the current manual of survey instructions of the United States Department of the Interior, Bureau of Land Management or by a decree of a Court of Law and/or that the corner points mentioned in lines 3, 4 and 5 above were in conformance with the rules of the Michigan Board of Land Surveyors or by a Decree of a Court of Law; established, re-established, monumented, re-monumented, recovered, found as expressed below:

NOTE: Not more than 4 corners, all in the same town and range, may be recorded on this certificate.

	A	B	C	D	E	F	G	H	I	J	K	L	M
2	6	5	4	3	2	1							
3													
4	7	8	9	10	11	12							
5													
6	18	17	16	15	14	13							
7													
8	19	20	21	22	23	24							
9													
10	30	29	28	27	26	25							
11													
12	31	32	33	34	35	36							
13													

A. Description of original monument and accessories and/or subsequent restoration:

J - 11 GLO Notes  
Set 1/4 Section Post: Beech 10 N 13 E 29, Beech 14 S445 W 21  
Act 74 Form NONE  
Act 132 Form NONE  
Unrecorded Survey Galbraith 5-1&2-1890, Survey Dated 8-26-88  
MDOT Right Way Book Page 55  
Road Comm NONE  
Drain Comm None


Approved Peer Board Meeting  
Dec. 16, 1994 gm

B. Description of corner evidence found and/or method applied in restoring or reestablishing corner:

J - 11  
S 1/4 Cor Section 26 T10N-R14E  
Found Monu Box - Raised Monu Box with Resurfacing

C. Description of monument for corner and accessories established to perpetuate locating the position of the corner:

J - 11  
S 1/4 Cor Section 26 T10N-R14E  
Found Monu Box  
S50°E 75.00 to a nail in a Tele Pole  
S45°W 54.00 to a nail in a Wooden Fence Post  
N40°W 92.50 to a nail in a Power Pole  
N20°W 39.60 to a Road Sign  
S10°E 63.40 to a Road Sign

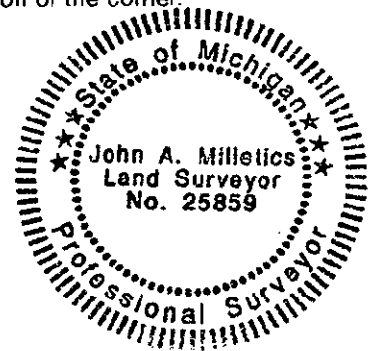

Signed by

*John A. Milletics*

Date

Dec 9, 1994

Surveyor's Michigan License No.

25859