REMONUMENTATION

LIBER 1 PAGE 470

RECEIVED FOR RECORD
94 AUG 12 PM 2:38
LIBER NO. 1 PAGE NO. 470
ESTHER LEE
REGISTER OF DEEDS
SANILAC CO., MICHIGAN

LAND CORNER RECORDATION CERTIFICATE
Filing Requirement of Act 74, Mich. P.A. 1970

For corners in Sanilac (County)

	Located In:	Corner Code #
1. Public Land Survey	T 10N R 14E	M - 2, M - 3
	T ___ R ___	
	T ___ R ___	
	T ___ R ___	
2. Property Controlling	S ___ T ___ R ___	
in Section	S ___ T ___ R ___	
3. Miscellaneous	S ___ T ___ R ___	
Property in Sec.	S ___ T ___ R ___	

Register of Deeds Stamp & File Number

4. Lot No. _____, Recorded Plat _____
5. Private Claims _____

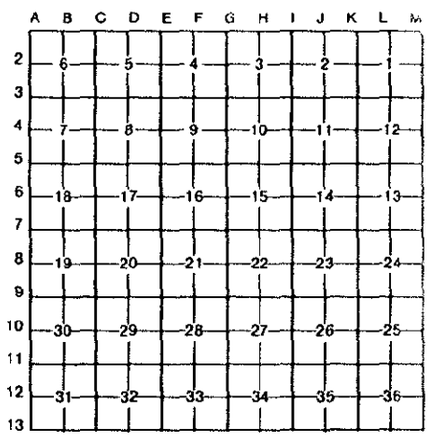

I, John A Milletics, in a field survey on July 11, 19 94, do hereby certify that under requirements of P.A. 74, Michigan P.A. of 1970, the corner points mentioned in lines 1 and 2 above were in conformance with regulations and rules therefore as required in the current manual of survey instructions of the United States Department of the Interior, Bureau of Land Management or by a decree of a Court of Law and/or that the corner points mentioned in lines 3, 4 and 5 above were in conformance with the rules of the Michigan Board of Land Surveyors or by a Decree of a Court of Law; established, re-established, monumented, re-monumented, recovered, found as expressed below:

NOTE: Not more than 4 corners, all in the same town and range, may be recorded on this certificate.

A. Description of original monument and accessories and/or subsequent restoration:

M - 2 Found 1/2" iron in Gravel Road Bed, as recorded in Liber 4 on Page 245 of the Sanilac County Records

M - 3 Found 1/2" iron Bar in Gravel Road Bed

Approved Peer Board Meeting
Aug. 9, 1994

B. Description of corner evidence found and/or method applied in restoring or reestablishing corner:

M - 2
E 1/4 Cor Section 1 T10N-R14E
Found 1/2" Iron Bar

M - 3
SE Cor Section 1 T10N-R13E
Found 1/2" Iron Bar

SURVEY &
REMONUMENTATION
SEP 07 1994
COMMISSION

C. Description of monument for corner and accessories established to perpetuate locating the position of the corner:

M - 2
E 1/4 Cor Section 1 T10N-R14E
1/2" Iron Bar
North 17.00 to a 1/2" iron bar
N80°W 46.80 to a nail in a Power Pole
N40°W 55.60 to a nail in a Tele Pole
N45°E 110.3 to the SW Cor of a House
North 4008.0 to the NE Cor of Section 1

M - 3
SE Cor Section 1 T10N-R14E
1/2" Iron Bar
N45°E 49.00 to a nail NE Side of a 24"Willow
S40°W 66.15 to a nail NE side of a Power Pole
N40°W 86.80 to a nail SW side of a Power Pole
S60°W 33.70 to a Stop Sign

Signed by John A Milletics Date July 23, 1994
Surveyor's Michigan License No. 25859

FORM APPROVED BY MICHIGAN STATE BOARD OF LAND SURVEYORS, JAN. 28, 1971
REVISED MAY 14, 1975
REVISED JAN., 1983