REMONUMENTATION

LIBER 1 PAGE 469

RECEIVED FOR RECORD
94 AUG 12 PM 2:38
LIBER NO. 1 PAGE NO. 469
ESTHER LEE
REGISTER OF DEEDS
SANILAC CO., MICHIGAN

LAND CORNER RECORDATION CERTIFICATE
Filing Requirement of Act 74, Mich. P.A. 1970

For corners in
Sanilac (County)

	Located In:	Corner Code ##
1. Public Land Survey	T 10N R 14E	M - 4, M - 5
	T ___ R ___	
	T ___ R ___	
	T ___ R ___	
2. Property Controlling	S ___ T ___ R ___	
in Section	S ___ T ___ R ___	
3. Miscellaneous	S ___ T ___ R ___	
Property in Sec.	S ___ T ___ R ___	

Register of Deeds Stamp & File Number

4. Lot No. _____ , Recorded Plat _____
5. Private Claims _____

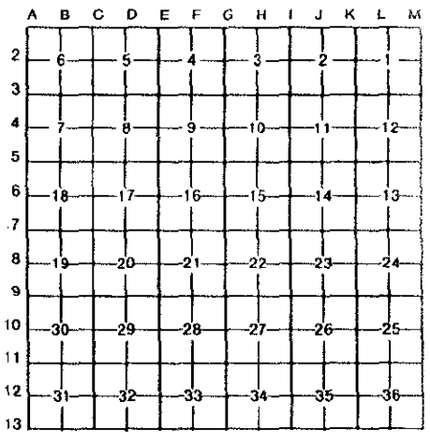

I, John A Milletics, in a field survey on July 11, 19 94, do hereby certify that under requirements of P.A. 74, Michigan P.A. of 1970, the corner points mentioned in lines 1 and 2 above were in conformance with regulations and rules therefore as required in the current manual of survey instructions of the United States Department of the Interior, Bureau of Land Management or by a decree of a Court of Law and/or that the corner points mentioned in lines 3, 4 and 5 above were in conformance with the rules of the Michigan Board of Land Surveyors or by a Decree of a Court of Law; established, re-established, monumented, re-monumented, recovered, found as expressed below:

NOTE: Not more than 4 corners, all in the same town and range, may be recorded on this certificate.

A. Description of original monument and accessories and/or subsequent restoration:

M - 4 Found no evidence of a exsiting corner on site

M - 5 Found 5/8" Iron bar in paved surface

Approved Peer Board Meeting
Aug. 9, 1994

B. Description of corner evidence found and/or method applied in restoring or reestablishing corner:

M - 4
E 1/4 Cor Section 12 T10N-R14E
Set 1/2" Iron straight line at half
between NE cor and SE cor of Section

M - 5
T10N-R14E
Found 5/8" Iron Bar

SURVEY &
REMONUMENTATION
SEP 07 1994
COMMISSION

C. Description of monument for corner and accessories established to perpetuate locating the position of the corner:

M - 4
E 1/4 Cor Section 12 T10N-R14E
1/2" iron bar in gravel road bed
N80°E 34.50 to a nail in a 8" Pine
N85°W 27.80 to the N End of a 24" CMP
S60°W 31.40 to the S. End of a 24"CMP
North 2615.00 to the NE Cor of Section 12
South 2615.00 to the SE Cor of Section 12

M - 5
SE Cor Section 12 T10N-R14E
Monu Box
N45°E 86.00 to a nail NW side of a Power Pole
N45°W 60.40 to a nail SW side of a 8" Pine
South 19.50 to the West leg of a Road Sign
S70°E 60.10 to a Road Sign
North 2615.00 to the E 1/4 Cor Section 12

Signed by _____ Date July 23 1994
Surveyor's Michigan License No. 25859

FORM APPROVED BY MICHIGAN STATE BOARD OF LAND SURVEYORS, JAN. 28, 1971
REVISED MAY 14, 1975
REVISED JAN., 1983