

FEB 22 1996

LIBER 2 PAGE 79

RECEIVED FOR RECORD

COMMISSION

LAND CORNER RECORDATION CERTIFICATE

95 DEC -6 PH 2:50

Filing Requirement of Act 74, Mich. P.A. 1970

LIBER NO. 2 PAGE NO. 79

or corners in

Sanilac

(County)

Located In:

Corner Code #

Public Land Survey

T 10N R 15E

B-5 C-5

Property Controlling in Section

S T R

Miscellaneous

S T R

Property in Sec.

S T R

Lot No. , Recorded Plat

Private Claims

ESTHER LEE REGISTER OF DEEDS SANILAC CO., MICHIGAN

Register of Deeds Stamp & File Number

John A Milletics in a field survey on Oct 6, 1995 hereby certify that under requirements of P.A. 74, Michigan P.A. of 1970, the corner points mentioned lines 1 and 2 above were in conformance with regulations and rules therefore as required in the current manual of survey instructions of the United States Department of the Interior, Bureau of Land Management or by a decree of a Court of Law and/or that the corner points mentioned in lines 3, 4 and 5 above were in conformance with the rules of the Michigan Board of Land Surveyors or by a Decree of a Court of Law; established, re-established, monumented, re-monumented, recovered, found as expressed below:

Grid table with columns A-M and rows 2-13. Contains numbers 1-36 in a grid pattern.

NOTE: Not more than 4 corners, all in the same town and range, may be recorded on this certificate.

Description of original monument and accessories and/or subsequent restoration:

B - 5

C - 5

GLO Notes

GLO Notes

Set 1/4 Post B Ash 10 N27W 18 Pine 6 S6E 4

Set Cor Post Pine 26 N55E 5 Pine 7 S53W 28

Act 74 None

Act 74 None

Act 132 None

Act 132 None

Unrecorded surveys Dated Aug 1978, June 1980, March 1986

Unrecorded surveys Dated Aug 1978, March 1986

Description of corner evidence found and/or method applied in restoring or reestablishing corner:

B - 5

C - 5

S 1/4 Cor Section 7 T10N-R15E

SE Cor Section 7 T10N-R15E


Found R/R Spike in Blacktop

Found 1" Bar in Blacktop

Approved Peer Board Meeting

Dec 6, 1995

Handwritten signature

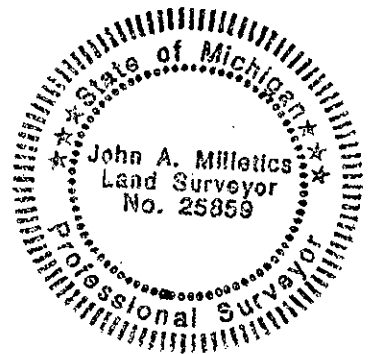

Description of monument for corner and accessories established to perpetuate locating the position of the corner:

B - 5

C - 5

S 1/4 Cor Section 7 T10N-R15E

SE Cor Section 7 T10N-R15E

Monu Box

Monu Box

North 1.6' to road centerline

North 5.0' to the centerline blacktop

N15°E 59.10' to nail in a Power Pole

S45°W 16.3' to a metal sign post

South 14.40' to the South edge of Bridge deck.

N75°E 165.1 to a nail in a Power Pole

S70°E 48.30 to a nail in guardrail post

West 2638.69 to the S 1/4 Cor of 7

S70°W 43.60 to a nail in guardrail post

Witnessed by

Handwritten signature of witness

Date Nov 23, 1995

Surveyor's Michigan License No.

25859