

REMONUMENTATION

FEB 22 1996

COMMISSION

LIBER 2 PAGE 78

RECEIVED FOR RECORD

LAND CORNER RECORDATION CERTIFICATE

95 DEC -6 PM 2:50

Filing Requirement of Act 74, Mich. P.A. 1970

LIBER NO. 2 PAGE NO. 78

For corners in

ESTHER LEE
REGISTER OF DEEDS
SANILAC CO., MICHIGAN

Sanilac (County)	Located In:	Corner Code #
1. Public Land Survey	T 10N R 15E	D - 5 E - 5
	T R	
	T R	
	T R	
2. Property Controlling in Section	S T R	
	S T R	
3. Miscellaneous Property in Sec.	S T R	
	S T R	

Register of Deeds Stamp & File Number

Lot No. _____, Recorded Plat _____
Private Claims _____

A	B	C	D	E	F	G	H	I	J	K	L	M
2	6	5	4	3	2	1						
3												
4	7	8	9	10	11	12						
5												
6	18	17	16	15	14	13						
7												
8	19	20	21	22	23	24						
9												
10	30	29	28	27	26	25						
11												
12	31	32	33	34	35	36						
13												

John A Milletics, in a field survey on Oct 6, 1995, hereby certify that under requirements of P.A. 74, Michigan P.A. of 1970, the corner points mentioned in lines 1 and 2 above were in conformance with regulations and rules therefore as required in the current manual of survey instructions of the United States Department of the Interior, Bureau of Land Management or by a decree of a Court of Law and/or that the corner points mentioned in lines 3, 4 and 5 above were in conformance with the rules of the Michigan Board of Land Surveyors or by a Decree of a Court of Law; established, re-established, monumented, re-monumented, recovered, found as expressed below:

NOTE: Not more than 4 corners, all in the same town and range, may be recorded on this certificate.

Description of original monument and accessories and/or subsequent restoration:


D - 5	E - 5
GLO Notes	GLO Notes
Set 1/4 Post at 40.51 B Ash 10 N27W 18 Pine 6 S6E 4	Set post at 80.0 Tamk 8 N80W 31 Cedar 5 S37E 17
Act 74 None	Act 74 None
Act 132 None	Act 132 Liber 3 Page 423
Unrecorded survey dated Dec 1992	

Description of corner evidence found and/or method applied in restoring or reestablishing corner:

D - 5	E - 5
S 1/4 Cor Section 8 T10N-R15E	SE Cor Section 8 T10N-R15E
Found 1" Bar in Blacktop	Found 5/8" iron bar in Blacktop

Approved Peer Board Meeting

Dec 6, 1995 *JM*

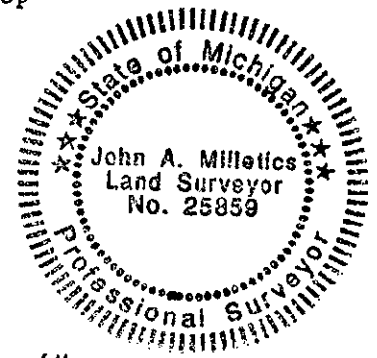

Description of monument for corner and accessories established to perpetuate locating the position of the corner:

D - 5	E - 5
S 1/4 Cor Section 8 T10N-R15E	SE Cor Section 8 T10N-R15E
Monu Box	Monu Box
North 7.1' to road centerline	North 3.0' to road centerline
South 22.3' to a nail in a Tele Pole	N45E 68.4 to a nail in a Anchor Pole
N05W 54.4 to a nail in a Power Pole	S45E 74.1 to a nail in a Power Pole
S45W 108.5 to the NE Cor of A House	S45W 68.9 to a nail in a Anchor Pole
	N45W 70.4 to a nail in a Power Pole

signed by *John A Milletics*

Date Nov 23, 1995

Surveyor's Michigan License No. 25859