

RECEIVED FOR RECORD

94 DEC 16 AM 9:41

REMONUMENTATION SURVEY & LAND CORNER RECORDATION CERTIFICATE  
Filing Requirement of Act 74, Mich. P.A. 1970

LIBER NO. 2 PAGE NO. 33  
ESTHER LEE  
REGISTER OF DEEDS  
SANILAC CO., MICHIGAN

For corners in Sanilac (County) Located in: Corner Code #

APR 10 1995

COMMISSION

- 1. Public Land Survey T10N R15E E-11  
T R  
T R  
T R
- 2. Property Controlling in Section S T R  
S T R
- 3. Miscellaneous Property in Sec. S T R  
S T R

Register of Deeds Stamp & File Number

- 4. Lot No. , Recorded Plat
- 5. Private Claims

I, John A Milletics, in a field survey on Aug 22, 1994, do hereby certify that under requirements of P.A. 74, Michigan P.A. of 1970, the corner points mentioned in lines 1 and 2 above were in conformance with regulations and rules therefore as required in the current manual of survey instructions of the United States Department of the Interior, Bureau of Land Management or by a decree of a Court of Law and/or that the corner points mentioned in lines 3, 4 and 5 above were in conformance with the rules of the Michigan Board of Land Surveyors or by a Decree of a Court of Law; established, re-established, monumented, re-monumented, recovered, found as expressed below:

NOTE: Not more than 4 corners, all in the same town and range, may be recorded on this certificate.

	A	B	C	D	E	F	G	H	I	J	K	L	M
2	6	5	4	3	2								
3													
4	7	8	9	10	11	12							
5													
6	18	17	16	15	14	13							
7													
8	19	20	21	22	23	24							
9													
10	30	29	28	27	26	25							
11													
12	31	32	33	34	35	36							
13													

A. Description of original monument and accessories and/or subsequent restoration:

E - 11 GLO Notes  
Set Post Corner: Sugar 16 S 67 E 24. Beech N 77 W 24  
Act 74 Form NONE  
Act 123 Form Liber 3 Page 611, Unrecorded Suvey dated 10-11-85

MDOT Right of Way Book Page 56

Road Comm NONE  
Drain Comm NONE


Approved Peer Board Meeting  
Dec. 16, 1994

B. Description of corner evidence found and/or method applied in restoring or reestablishing corner:

E - 11  
SE Corner Section 29 T10N-R15E  
Found Monu Box - Raised Monu Box during Resurfacing

C. Description of monument for corner and accessories established to perpetuate locating the position of the corner:

E - 11  
SE Corner Section 29 T10N-R15E  
Found Monu Box  
S45W 87.00 to a nail in a Power Pole  
N45°W 90.60 to a nail in a Power Pole  
N30°W 58.00 to the East leg of a Road Sign  
S10°E 39.40 to a Road Sign  
N45°E 51.15 to a Road Sign

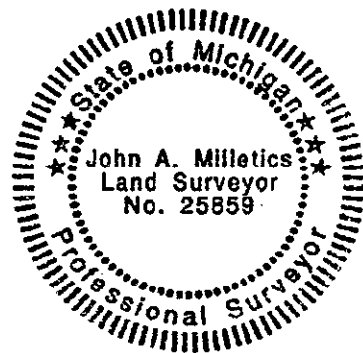

Signed by [Signature]

Date Dec 10, 1994

Surveyor's Michigan License No. 25859