LIBER 1 PAGE 401

RECEIVED FOR RECORD

93 DEC 15 PM 3: 18

LIBER NO. 1 PAGE NO. 401
ESTHER LEE
REGISTER OF DEEDS
SANILAC CO., MICHIGAN

REMONUMENTATION CORNER

LAND CORNER RECORDATION CERTIFICATE

Filing Requirement of Act 74, Mich. P.A. 1970

For corners in

Sanilac (County)

		Located In:	Corner Code ##
1. Public Land Survey		T 10N R 15E	G - 1, F - 1
		T ___ R ___	
		T ___ R ___	
		T ___ R ___	
2. Property Controlling	S ___	T ___ R ___	
in Section	S ___	T ___ R ___	
3. Miscellaneous	S ___	T ___ R ___	
Property in Sec.	S ___	T ___ R ___	

Register of Deeds Stamp & File Number

4. Lot No. _____ , Recorded Plat _____
5. Private Claims _____

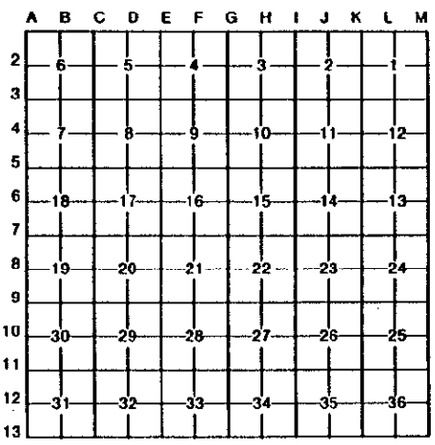

I, John A Milletics, in a field survey on Nov 3, 19 93, do hereby certify that under requirements of P.A. 74, Michigan P.A. of 1970, the corner points mentioned in lines 1 and 2 above were in conformance with regulations and rules therefore as required in the current manual of survey instructions of the United States Department of the Interior, Bureau of Land Management or by a decree of a Court of Law and/or that the corner points mentioned in lines 3, 4 and 5 above were in conformance with the rules of the Michigan Board of Land Surveyors or by a Decree of a Court of Law; established, re-established, monumented, re-monumented, recovered, found as expressed below:

NOTE: Not more than 4 corners, all in the same town and range, may be recorded on this certificate.

A. Description of original monument and accessories and/or subsequent restoration:

G - 1 Found 1" bar in road bed, per survey recorded in Liber 4, Page 3 of the Sanilac County Records.

F - 1 Found 1/2" iron bar in gravel road bed, per survey recorded in Liber 4, Page 3 of the Sanilac County Records.

B. Description of corner evidence found and/or method applied in restoring or reestablishing corner:

G - 1
NE Cor Section 4 T10N-R15E
Found 1" Bar in gravel road bed

F - 1
N 1/4 Cor Section 4 T10N-R15E
Found 1/2" iron in gravel road bed

SURVEY &
REMONUMENTATION
1993
COMMISSION

C. Description of monument for corner and accessories established to perpetuate locating the position of the corner:

G - 1
NE Cor Section 4 T10N-R15E
Found 1" bar
North 22.50' to the West leg of a road sign
N35°E 71.00' to a nail in a Power Pole
S45°E 67.85' to a nail in a 8" Elm
S75°E 90.02' to a nail in a 12" Elm

F - 1
N 1/4 Cor Section 4 T10N-R15E
Found 1/2" Iron
South 33.00' to a 1/2" iron bar
N20°E 27.60' to a nail in a 12"ash
S45°W 36.40' to a nail in a 18"ash
S45°E 41.20' to a nail in a 8"pine

Signed by John A Milletics Date Dec 17, 1993

Surveyor's Michigan License No. 25859

FORM APPROVED BY MICHIGAN STATE BOARD OF LAND SURVEYORS, JAN. 28, 1971
REVISED MAY 14, 1975
REVISED JAN., 1983