

REMONUMENTATION

FEB 22 1996

LIBER 2 PAGE 76

RECEIVED FOR RECORD

COMMISSION

LAND CORNER RECORDATION CERTIFICATE
Filing Requirement of Act 74, Mich. P.A. 1970

95 DEC -6 PM 2:50

For _____
Sanilac
(County)

Located In: Corner Code #
1. Public Land Survey T 10N R 15E H - 5 I - 5
T _____ R _____
T _____ R _____
T _____ R _____
2. Property Controlling S _____ T _____ R _____
in Section S _____ T _____ R _____
3. Miscellaneous S _____ T _____ R _____
Property in Sec. S _____ T _____ R _____

LIBER NO. 2 PAGE NO. 76
ESTHER LEE
REGISTER OF DEEDS
SANILAC CO., MICHIGAN.

Register of Deeds Stamp & File Number

4. Lot No. _____, Recorded Plat _____
5. Private Claims _____

John A Milletics, in a field survey on Oct 6, 19 95, do hereby certify that under requirements of P.A. 74, Michigan P.A. of 1970, the corner points mentioned in lines 1 and 2 above were in conformance with regulations and rules therefore as required in the current manual of survey instructions of the United States Department of the Interior, Bureau of Land Management or by a decree of a Court of Law and/or that the corner points mentioned in lines 3, 4 and 5 above were in conformance with the rules of the Michigan Board of Land Surveyors or by a Decree of a Court of Law; established, re-established, monumented, re-monumented, recovered, found as expressed below:

A	B	C	D	E	F	G	H	I	J	K	L	M
2	6	5	4	3	2	1						
3												
4	7	8	9	10	11	12						
5												
6	18	17	16	15	14	13						
7												
8	19	20	21	22	23	24						
9												
10	30	29	28	27	26	25						
11												
12	31	32	33	34	35	36						
13												

NOTE: Not more than 4 corners, all in the same town and range, may be recorded on this certificate.

A. Description of original monument and accessories and/or subsequent restoration:


H - 5	I - 5
GLO Notes	GLO Notes
Set 1/4 Post at 39.90 Spruce 3 North 7 Spruce 4 S10E 20	Set Cor Post Cedar 9 N57E 16 Cedar 7 S45W 17
Act 74 None	Act 74 None
Act 132 None	Act 132 None
Old Survey Liber None	Old Survey Liber Page 336 April 1890. Page 344 Oct 1890. Page 402 Nov 1893

B. Description of corner evidence found and/or method applied in restoring or reestablishing corner:

H - 5	I - 5
S 1/4 Cor Section 10 T10N-R15E	SE Cor Section 10 T10N-R15E
Found 1/2" Iron bar on line between SE and SW Cors at Half 2632.64'	Found P.K. Nail in bridge deck

Approved Peer Board Meeting

Dec. 6, 1995 [Signature]

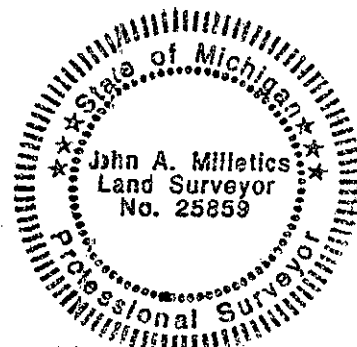

C. Description of monument for corner and accessories established to perpetuate locating the position of the corner:

H - 5	I - 5
S 1/4 Cor Section 10 T10N-R15E	SE Cor Section 10 T10N-R15E
1/2" iron bar in gravel road bed	P.K. Nail in Bridge Deck
N30W 23.6 to the North end of a 24" CMP	East 5.0 to a 1/2" Iron Bar
S30W 18.8 to the South end of a 24" CMP	North 50.00 to a 1/2" Iron Bar
East 2632.64 to the SE Cor	North 7.3 to the N. Edge of the Bridge Deck
West 2632.64 to the SW Cor	N70°W 27.5 to the North cor of NW Wing Wall
	S70°W 27.9 to the South cor of SW Wing Wall

igned by [Signature]
urveyor's Michigan License No. 25859

Date Nov 23 1995