

MONUMENTATION

LIBER 2 PAGE 75

RECEIVED FOR RECORD

FEB 22 1996

LAND CORNER RECORDATION CERTIFICATE

95 DEC -6 PM 2:50

Filing Requirement of Act 74, Mich. P.A. 1970

LIBER NO. 2 PAGE NO. 75

For corners in COMMISSION

ESTHER LEE
REGISTER OF DEEDS
SANILAC CO., MICHIGAN

Sanilac (County)	Located In:	Corner Code #
1. Public Land Survey	T 10N R 15E	J - 5 K - 5
	T R	
	T R	
	T R	
2. Property Controlling in Section	S T R	
	S T R	
3. Miscellaneous Property in Sec.	S T R	
	S T R	

Register of Deeds Stamp & File Number

Lot No. , Recorded Plat
Private Claims

A	B	C	D	E	F	G	H	I	J	K	L	M
2	6	5	4	3	2	1						
3												
4	7	8	9	10	11	12						
5												
6	18	17	16	15	14	13						
7												
8	19	20	21	22	23	24						
9												
10	30	29	28	27	26	25						
11												
12	31	32	33	34	35	36						
13												

John A Milletics, in a field survey on Oct 6, 1995, hereby certify that under requirements of P.A. 74, Michigan P.A. of 1970, the corner points mentioned in lines 1 and 2 above were in conformance with regulations and rules therefore as required in the current manual of survey instructions of the United States Department of the Interior, Bureau of Land Management or by a decree of a Court of Law and/or that the corner points mentioned in lines 3, 4 and 5 above were in conformance with the rules of the Michigan Board of Land Surveyors or by a Decree of a Court of Law; established, re-established, monumented, re-monumented, recovered, found as expressed below:

NOTE: Not more than 4 corners, all in the same town and range, may be recorded on this certificate.

Description of original monument and accessories and/or subsequent restoration:


J - 5	K - 5
GLO Notes	GLO Notes
Set 1/4 Post at 40.17 1/2 Tamk 8 N28E 33	Set Post at 80 Hemlock 16 S36 1/2 E 20
Cedar 9 23 1/2 41	Hemlock 6 N15W 26
Act 74 None	Act 74 None
Act 132 None	Act 132 None
Old Survey Liber Page 344 Oct 1890, Nov 1893	Unrecorded Survey Dated May 1980
Page 420, April 1890 Page 337	Old Survey Liber Page 344 Oct 1890, Nov 1894
	Page 420

Description of corner evidence found and/or method applied in restoring or reestablishing corner:

J - 5	K - 5
S 1/4 Cor Section 11 T10N-R15E	SE Cor Section 11 T10N-R15E
Found 1/2" Iron Bar	Found 1/2" Iron Bar

Approved Peer Board Meeting

Dec 6, 1995 *JM*

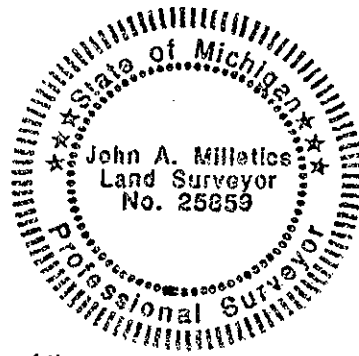

Description of monument for corner and accessories established to perpetuate locating the position of the corner:

J - 5	K - 5
S 1/4 Cor Section 11 T10N-R15E	SE Cor Section 11 T10N-R15E
1/2" Iron Bar in gravel Road Bed	1/2" Iron Bar in gravel road bed
South 33.00 to the SE Cor of a Conc Pillor	S60°E 60.6 to a nail in a Anchor Pole
North 69.0 to the nail in a 6" Ash	S45W 43.95 to a nail in a Tele Pole
N70W 123.1 to a nail in a Power Pole	N45W 45.40 to a nail in a Fence Post
North 33.00 to a 1/2" Iron Bar	S45E 36.30 to a stop sign

Signed by *John A. Milletics* Date Nov 23, 1995
Surveyor's Michigan License No. 25859