LIBER 1 PAGE 478

REMONUMENTATION

SURVEY & REMONUMENTATION COMMISSION APR 1 0 1995

LAND CORNER RECORDATION CERTIFICATE

Filing Requirement of Act 74, Mich. P.A. 1970

For corners in Sanilac (County)

RECEIVED FOR RECORD
94 DEC 16 AM 9:39
LIBER NO. 1 PAGE NO. 478
ESTHER LEE
REGISTER OF DEEDS
SANILAC CO., MICHIGAN

Register of Deeds Stamp & File Number

	Located In:	Corner Code ##
1. Public Land Survey	T 10N R 16E	B - 11
	T ___ R ___	
	T ___ R ___	
	T ___ R ___	
2. Property Controlling	S ___ T ___ R ___	
in Section	S ___ T ___ R ___	
3. Miscellaneous	S ___ T ___ R ___	
Property in Sec.	S ___ T ___ R ___	

4. Lot No. _____ , Recorded Plat _____
5. Private Claims _____

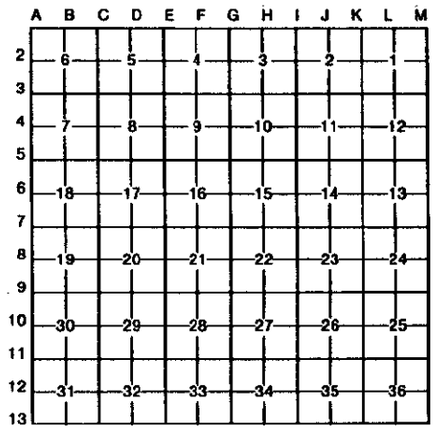

I, John A Milletics, in a field survey on Aug 31, 19 94, do hereby certify that under requirements of P.A. 74, Michigan P.A. of 1970, the corner points mentioned in lines 1 and 2 above were in conformance with regulations and rules therefore as required in the current manual of survey instructions of the United States Department of the Interior, Bureau of Land Management or by a decree of a Court of Law and/or that the corner points mentioned in lines 3, 4 and 5 above were in conformance with the rules of the Michigan Board of Land Surveyors or by a Decree of a Court of Law; established, re-established, monumented, re-monumented, recovered, found as expressed below:

NOTE: Not more than 4 corners, all in the same town and range, may be recorded on this certificate.

A. Description of original monument and accessories and/or subsequent restoration:

B - 11 GLO Notes
Set ¼ Section Post: Birch 13 N 19 E 22½, Pine 32 S 17 W 27

Act 74 Form Liber 1 Page 283
Act 132 Form Liber 3 Page 521, Liber 3 Page 293
Unrecorded Surveys Dated 11-12-86, Dated 1-27-89

MDOT Right of Way Book Page 57

Road Comm NONE
Drain Comm NONE

B. Description of corner evidence found and/or method applied in restoring or reestablishing corner:

B - 11
S 1/4 Corner Section 30 T10N-R16E
Found Monu Box - Raised during Resurfacing

Approved Peer Board Meeting
Dec 16, 1994 gm

C. Description of monument for corner and accessories established to perpetuate locating the position of the corner:

B - 11
S 1/4 Corner Section 30 T10N-R16E
Found Monu Box
S05°E 50.70 to a nail in a Tele Pole
S30°W 49.05 to a nail in a 4" Ash
N55°W 123.8 to a nail in a Power Pole
S15°E 50.65 to a nail in a 4" Ash
Monu Box exists on Road Centerline

State of Michigan
John A. Milletics
Land Surveyor
No. 25859
Professional Surveyor

Signed by John A Milletics Date Dec 11, 1994

Surveyor's Michigan License No. 25859

FORM APPROVED BY MICHIGAN STATE BOARD OF LAND SURVEYORS, JAN. 28, 1971
REVISED MAY 14, 1975
REVISED JAN., 1983